

### LABOR AND MATERIALS

Copper Lead Connection 3/4 \$ \_\_\_\_\_  
 Curb } Cock \_\_\_\_\_ in. \$ \_\_\_\_\_  
       } Valve \_\_\_\_\_  
       } T.S. & V. \_\_\_\_\_  
 Service box { Short 3-1/2 x 4-1/2 } \$ \_\_\_\_\_  
 Old returned { Long 4-1/2 x 5-1/2 } \_\_\_\_\_  
 Ft. \_\_\_\_\_ in. { Copper } Pipe at \_\_\_\_\_ \$ \_\_\_\_\_  
                                   { G.I. }  
                                   { C.I. }  
 Nipples \_\_\_\_\_ in. at \_\_\_\_\_ \$ \_\_\_\_\_  
 Bushings \_\_\_\_\_ to \_\_\_\_\_ in. at \_\_\_\_\_ \$ \_\_\_\_\_  
 Red'g \_\_\_\_\_  
 Inc'g \_\_\_\_\_  
 Union \_\_\_\_\_ in. at \_\_\_\_\_ \$ \_\_\_\_\_  
 Meter \_\_\_\_\_ in. at \_\_\_\_\_ \$ \_\_\_\_\_  
 \_\_\_\_\_ \$ \_\_\_\_\_  
 Compound Joints at \_\_\_\_\_ \$ \_\_\_\_\_  
 Maintenance Foreman \_\_\_\_\_ \$ \_\_\_\_\_  
 Hrs. Water Maint. Man - 1 at \_\_\_\_\_ \$ \_\_\_\_\_  
 Hrs. Water Maint. Man - 2 at \_\_\_\_\_ \$ \_\_\_\_\_  
 Hrs. Garage Foreman \_\_\_\_\_ at \_\_\_\_\_ \$ \_\_\_\_\_  
 Hrs. Labor \_\_\_\_\_ at \_\_\_\_\_ \$ \_\_\_\_\_  
 Hrs. Compressor at \_\_\_\_\_ \$ \_\_\_\_\_  
 \_\_\_\_\_ \$ \_\_\_\_\_  
 Trucking \_\_\_\_\_ \$ \_\_\_\_\_  
 Pav't Patch \_\_\_\_\_ \$ \_\_\_\_\_  
 \_\_\_\_\_ \$ \_\_\_\_\_  
 \_\_\_\_\_ \$ \_\_\_\_\_  
 \_\_\_\_\_ \$ \_\_\_\_\_  
 \_\_\_\_\_ \$ \_\_\_\_\_


RESERVOIR

St. Pl. Ave. No. 16

Name of Owner

TAX ID # 302.17-4-15

Labor and Mat'l. Report 19

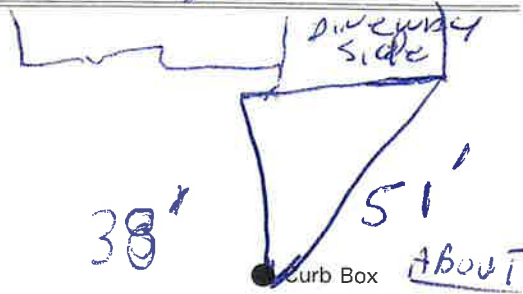

\_\_\_\_\_ Main Elev. of Main at tap \_\_\_\_\_

Gate at ● Two shut on Gate at ●

Some live and meter

● Curb Box

TAP CLARK ROAD  
 Side  
 Found Two Live  
 put meter on one  
 (3/4 lines) (that shut house)  
 off

# LABOR AND MATERIALS


Copper } Connection \_\_\_\_\_ \$ \_\_\_\_\_  
 Lead }  
 Curb } Cock \_\_\_\_\_ in. \_\_\_\_\_ \$ \_\_\_\_\_  
 Valve }  
 T.S. & V. }  
 Service box { Short 3-1/2 x 4-1/2 } \_\_\_\_\_ \$ \_\_\_\_\_  
 Old returned { Long 4-1/2 x 5-1/2 }  
 Ft. \_\_\_\_\_ in. { Copper } Pipe at \_\_\_\_\_ \$ \_\_\_\_\_  
 { G.I. }  
 { C.I. }  
 Nipples \_\_\_\_\_ in. at \_\_\_\_\_ \$ \_\_\_\_\_  
 Bushings \_\_\_\_\_ to \_\_\_\_\_ in. at \_\_\_\_\_ \$ \_\_\_\_\_  
 Red'g \_\_\_\_\_  
 Inc'g \_\_\_\_\_  
 Union \_\_\_\_\_ in. at \_\_\_\_\_ \$ \_\_\_\_\_  
 Meter \_\_\_\_\_ in. at \_\_\_\_\_ \$ \_\_\_\_\_  
 Compound Joints at \_\_\_\_\_ \$ \_\_\_\_\_  
 Maintenance Foreman \_\_\_\_\_ \$ \_\_\_\_\_  
 Hrs. Water Maint. Man - 1 at \_\_\_\_\_ \$ \_\_\_\_\_  
 Hrs. Water Maint. Man - 2 at \_\_\_\_\_ \$ \_\_\_\_\_  
 Hrs. Garage Foreman \_\_\_\_\_ at \_\_\_\_\_ \$ \_\_\_\_\_  
 Hrs. Labor \_\_\_\_\_ at \_\_\_\_\_ \$ \_\_\_\_\_  
 Hrs. Compressor at \_\_\_\_\_ \$ \_\_\_\_\_  
 Trucking \_\_\_\_\_ \$ \_\_\_\_\_  
 Pav't Patch \_\_\_\_\_ \$ \_\_\_\_\_  
 \_\_\_\_\_ \$ \_\_\_\_\_  
 \_\_\_\_\_ \$ \_\_\_\_\_  
RESERVOIR

St. 16  
 Pl. Ave. No. 16

Name of Owner \_\_\_\_\_

10/17/07  
 Labor and Mat'l. Report ~~to~~ 2007

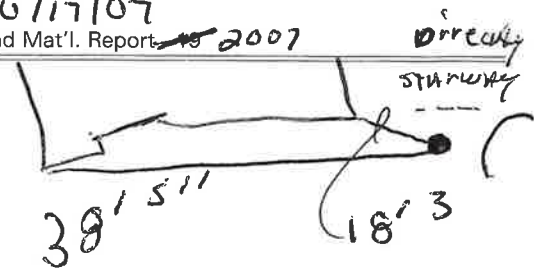

● Curb Box

\_\_\_\_\_ Main Elev. of Main at tap \_\_\_\_\_  
 Gate at ● Gate at ●

● Curb Box

1st  
 shut  
 off


LABOR AND MATERIALS

1 Copper } Connection  $\frac{3}{4}$ " \$ \_\_\_\_\_  
 1 Lead }  
 1 Curb } Cock }  
 } Valve }  
 } T.S. & V. } 1" in. "Nipple" \$ \_\_\_\_\_  
 1 Service box } Short  $3\frac{1}{2}$  x  $4\frac{1}{2}$  }  
 Old returned } Long  $4\frac{1}{2}$  x  $5\frac{1}{2}$  } 5' x 6" \$ \_\_\_\_\_  
 } Buff or Rdway } \$ \_\_\_\_\_  
 109 Ft.  $\frac{3}{4}$  in. } Copper } Pipe at \$ \_\_\_\_\_  
 } C.I. }  
 } C.I. }  
 Nipples in. at \$ \_\_\_\_\_  
 Bushings to in. at \$ \_\_\_\_\_  
 Red'g } Coupl'gs to in. at \$ \_\_\_\_\_  
 Inc'g }  
 Union in. at \$ \_\_\_\_\_  
 Meter in. at \$ \_\_\_\_\_  
 Lead Joints at \$ \_\_\_\_\_  
 Compound Joints at \$ \_\_\_\_\_  
 Maintenance Foreman \$ \_\_\_\_\_  
 Hrs. Water Maint. Man-1 at \$ \_\_\_\_\_  
 Hrs. Water Maint. Man-2 at \$ \_\_\_\_\_  
 Hrs. Garage Foreman at \$ \_\_\_\_\_  
 Hrs. Labor at \$ \_\_\_\_\_  
 Hrs. Compressor at \$ \_\_\_\_\_  
 Compensation Ins. at \$ \_\_\_\_\_ per C \$ \_\_\_\_\_  
 Trucking \$ \_\_\_\_\_  
 Pav't Patch \$ \_\_\_\_\_  
 Tap by Gifford & Co. \$ \_\_\_\_\_  
 10-30-59. \$ \_\_\_\_\_  
 O'head \$ \_\_\_\_\_  
 \$ \_\_\_\_\_

Note: ONLY  
 25' -  $\frac{3}{4}$ " K. Copper  
 Furnished by Dept.

St.   
 Pl.   
 Reservoir Dr. Ave. No. 16  
 Name of Owner Hay Nitz

Labor and Mat'l. Report Oct. 30 1959

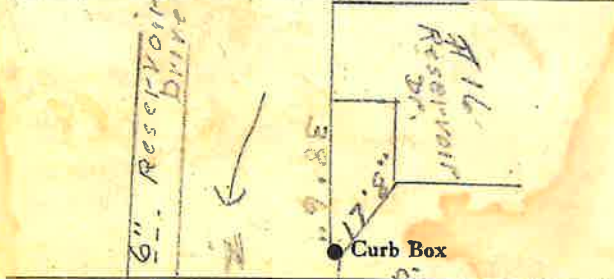

Tap 109' -  $3\frac{1}{8}$ " Clark St.  
 6" Main Asbestos Elev. of  
 Main cement, Main at tap 5'

Gate at • Gate at •

• Curb Box  
 This Tap on  
 Reservoir Dr.  
 Use yellow Tee (T)  
 Wrench to  
 Shut off & turn on.

WATER DEPARTMENT

City of Glens Falls, New York

Over 5-31- 1960.

A. M. \_\_\_\_\_ P. M.

M Rod To short

Tel. Call: use

Turn on: yellow (T)

Shut off: \_\_\_\_\_

Leak: tee wrench

Raise curb box

Misc. 16 Reservoir Dr  
Rodgers.

REMARKS:

Dug up & replaced

3 1/2" x 4 1/2" box & Rod.

With 5" x 6" box & Rod.

And Added 14" 1/2"

Nipple. 6-3-60.

By: \_\_\_\_\_ From: \_\_\_\_\_ To: \_\_\_\_\_