

### LABOR AND MATERIALS


1	Copper Lead	Connection	3/4"	\$	308
1	Curb	Cock Valve T.S. & V.	3/4 in.	\$	389
1	Service box	Short 3 1/2 x 4 1/2		\$	432
	Old returned	Long 4 1/2 x 5 1/2		\$	
		Buff or Rdway		\$	
25	Ft. 3/4 in.	Copper Pipe at	45	\$	11.25
		G.I.		\$	
		G.I.		\$	
	Nipples	in. at		\$	
	Bushings	to in. at		\$	
	Red'g Inc'g	Coupl'gs to in. at		\$	
	Union	in. at		\$	
	Meter	in. at		\$	
	Lead Joints	at		\$	
	Compound Joints	at		\$	
2	Maintenance Foreman		1937	\$	387
	Hrs. Water Maint. Man-1	at		\$	
	Hrs. Water Maint. Man-2	at		\$	
	Hrs. Garage Foreman	at		\$	
2	Hrs. Labor	at	1481	\$	296
	Hrs. Compressor	at		\$	
	Compensation Ins. at	\$5.686 per C.		\$	39
	Trucking			\$	1.50
	Pav't Patch			\$	
	Tap by Miller			\$	
	FOSMER-10-25-56			\$	
	O'head			\$	
				\$	31.26

Lot ?

St. \_\_\_\_\_  
Pl. \_\_\_\_\_  
Ave. No. 24

Name of Owner  
Grant

Labor and Mat'l. Report Oct 25 19 56

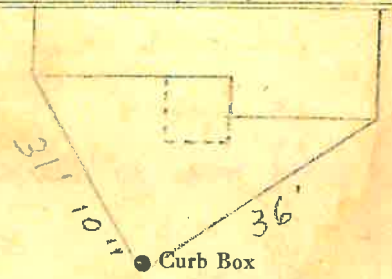

Transite  
6" Main  
Elev. of Main at tap 5'

Gate at ● Gate at ●

● Curb Box