


LABOR AND MATERIALS

1 Copper Lead	Connection	3/4"	\$ 308
1 Curb	Cock Valve T.S. & V.	3/4 in.	\$ 399
1 Service box Old returned	Short 3 1/2 x 4 1/2 Long 4 1/2 x 5 1/2 Buff or Rdway		\$ 432
26 Ft. 3/4" in.	Copper G.I. Pipe at	45	\$ 1170
Nipples	in. at		\$
Bushings	to in. at		\$
Red'g Inc'g	Coupl'gs to in. at		\$
Union	in. at		\$
Meter	in. at		\$
Lead Joints	at		\$
Compound Joints	at		\$
Maintenance Foreman			\$
Hrs. Water Maint. Man-1	at		\$
Hrs. Water Maint. Man-2	at		\$
Hrs. Garage Foreman	at		\$
Hrs. Labor	at 1.30		\$ 540
Hrs. Compressor	at		\$
Compensation Ins.	at \$ 5.686 per C.		\$ 30
Trucking			\$ 1.50
Pax't Patch			\$
Top made Aug 10-56			\$
Wadleigh & Putney			\$
O'head			\$
			\$ 2999

Reservoir Drive St. Lot
Pl. Ave. No. 28

Name of Owner
Hay Sold To Winters

Labor and Mat'l. Report Aug 10 1956

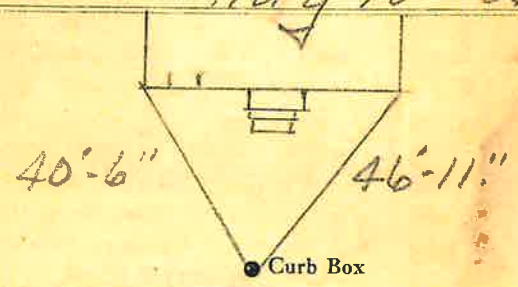

6" Transite Main Elev. of Main at tap 4 1/2'

Gate at • • Gate at

• Curb Box