

LABOR AND MATERIALS

1	Copper Lead	Connection	3/4"	\$	3.08
1	Curb	Cock Valve T. S. & V.	3/4 in.	\$	3.89
1	Service box Old returned	Short 3 1/2 x 4 1/2 Long 4 1/2 x 5 1/2 Buff or Rdway		\$	4.32
13	Ft. 3/4 in.	Copper G.I. G.I.	Pipe at 45	\$	5.85
	Nipples	in. at		\$	
	Bushings	to in. at		\$	
	Red'g Inc'g	Coupl'gs to in. at		\$	
	Union	in. at		\$	
	Meter	in. at		\$	
	Lead Joints	at		\$	
	Compound Joints	at		\$	
	Maintenance Foreman			\$	
	Hrs. Water Maint. Man-1	at		\$	
2	Hrs. Water Maint. Man-2	at 16.13		\$	3.23
	Hrs. Garage Foreman	at		\$	
2	Hrs. Labor	at 1.30		\$	2.60
	Hrs. Compressor	at		\$	
	Compensation Ins.	at \$5.686 per C		\$	33
	Trucking			\$	1.50
	Pay't Patch			\$	
	Tap made	8-15-56		\$	
	by	Gilford		\$	
	O'head			\$	
				\$	24.80


Sub
Divin

Reservoir Drive
Roethne

St. Lot 9
Pl. 2
Ave. No. 2

Name of Owner
Roethne

Labor and Mat'l. Report Aug 15 1956

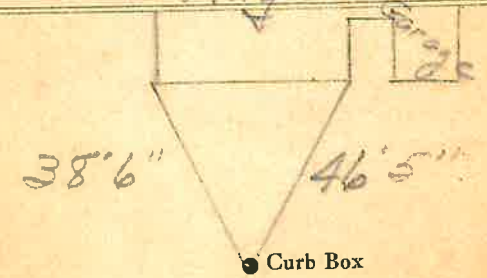

6" Transite Main Elev. of Main at tap 4'

Gate at • Gate at

TAX ID # 302.13-1-26

• Curb Box

Main in the Middle of the Road