

LABOR AND MATERIALS

1	Copper	Connection	3/4"	\$
1	Lead			\$
1	Curb	Cock Valve	3/4 in.	\$
		T.S. & V.		
1	Service box	Short 3 1/2 x 4 1/2		\$
	Old returned	Long 4 1/2 x 5 1/2		\$
		Buff or Rdway		\$
32	3/4 in.	Copper	Pipe at	\$
		G.I.		\$
		G.I.		\$
	Nipples	in. at		\$
	Bushings	to in. at		\$
	Red'g			\$
	Inc'g	Coupl'gs to in. at		\$
	Union	in. at		\$
	Meter	in. at		\$
	Lead Joints	at		\$
	Compound Joints	at		\$
	Maintenance Foreman			\$
	Hrs. Water Maint. Man-1	at		\$
	Hrs. Water Maint. Man-2	at		\$
	Hrs. Garage Foreman	at		\$
	Hrs. Labor	at		\$
	Hrs. Compressor	at		\$
	Compensation Ins.	at \$ per C		\$
	Trucking			\$
	Pav't Patch			\$
	Tap by Gifford &			\$
	Peter 5017	4-8-57		\$
	O'head			\$


*Roll 17/10 375*

Lot-24 ✓

St.   
 Pl.   
 Ave. No. 5

Name of Owner   
 Frank Costello

Labor and Mat'l. Report Apr. 8 1957

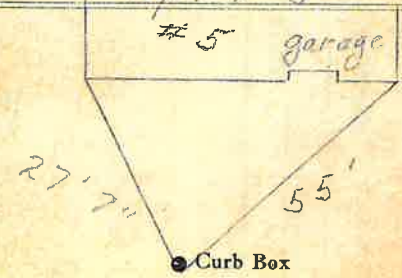

Transite   
 6" Main Elev. of Main at tap 5'

Gate at • Gate at •

TAX ID # 302.13-1-29

• Curb Box

Water Main in the Middle of the Road