

LABOR AND MATERIALS


| | | | | |
|----|----------------------------|------------------------------------------------------------|---------|----|
| 1 | Copper Lead | Connection | 3/4" | \$ |
| 1 | Curb | Cock Valve T.S. & V. | 3/4 in. | \$ |
| 1 | Service box - Old returned | Short 3 1/2 x 4 1/2 Long 4 1/2 x 5 1/2 Buff or Rdway | | \$ |
| 24 | 3/4 in. | Copper G.I. C.I. | Pipe at | \$ |
| | Nipples | in. at | | \$ |
| | Bushings | to in. at | | \$ |
| | Red'g Inc'g | Coupl'gs to in. at | | \$ |
| | Union | in. at | | \$ |
| | Meter | in. at | | \$ |
| | Lead Joints | at | | \$ |
| | Compound Joints | at | | \$ |
| | Maintenance Foreman | | | \$ |
| | Hrs. Water Maint. Man-1 | at | | \$ |
| | Hrs. Water Maint. Man-2 | at | | \$ |
| | Hrs. Garage Foreman | at | | \$ |
| | Hrs. Labor | at | | \$ |
| | Hrs. Compressor | at | | \$ |
| | Compensation Ins. | at \$ per C | | \$ |
| | Trucking | | | \$ |
| | Pav't Patch | | | \$ |
| | Tap by Gifford & Peterson | | | \$ |
| | 4-8-57 | | | \$ |
| | O'head | | | \$ |

Lot-27 ✓

Reservoir Dr. -St.
-Pl.
Ave. No. 6

Name of Owner
Clifford Nelson

Labor and Mat'l. Report Apr. 8 1957

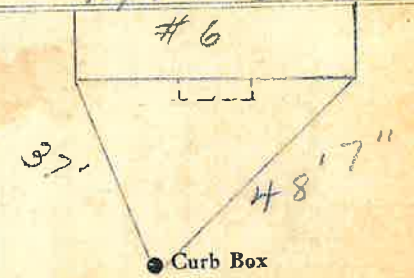

Transite
6" Main Elev. of
Main at tap 5'

Gate at • • Gate at

TAX ID #302.13-1-28

• Curb Box

Water Main in the Middle
of the Road