

LABOR AND MATERIALS


1	Copper Lead	Connection	3/4"	\$
1	Curb	Cock Valve	3/4 in.	\$
1	Service box	Short 3 1/2 x 4 1/2		
	Old returned	Long 4 1/2 x 5 1/2		
		Buff or Rdway		\$
23	23 Ft. 3/4 in.	Copper Pipe at		\$
		G.I.		
		G.I.		
	Nipples	in. at		\$
	Bushings	to in. at		\$
	Red'g			
	Inc'g	Coupl'gs to in. at		\$
	Union	in. at		\$
	Meter	in. at		\$
	Lead Joints	at		\$
	Compound Joints	at		\$
	Maintenance Foreman			\$
	Hrs. Water Maint. Man	1 at		\$
	Hrs. Water Maint. Man	2 at		\$
	Hrs. Garage Foreman	at		\$
	Hrs. Labor	at		\$
	Hrs. Compressor	at		\$
	Compensation Ins.	at \$ per C		\$
	Trucking			\$
	Pav't Patch			\$
	Tap by Gifford			\$
	4-6-56-14-57			\$
	O'head			\$
				\$

Lot-23 ✓

Reservoir St. D1. ✓  
Pl. Ave. No. 7

Name of Owner  
Hay

Labor and Mat'l. Report June 14 1957

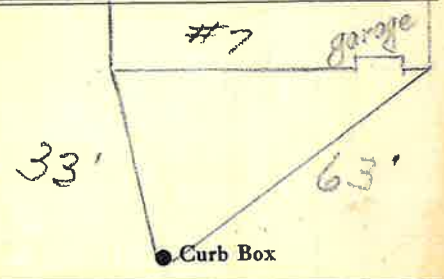

Transite  
6" Main Elev. of Main at tap 4 1/2'

Gate at • Gate at  
TAX ID # 302.17-4-10

• Curb Box

Repaired water main break  
Sept. 8, 2009 @ this address  
Main in middle of the Road