

## LABOR AND MATERIALS


1	Copper	Connection	3/4"		\$
	<del>Lead</del>				
1	Curb	Cock Valve	3/4 in.		\$
		T. S. & V.			
1	Service box	}	Short 3 1/2 x 4 1/2		
	Old returned		Long 4 1/2 x 5 1/2		\$
			Buff or Rdway		
24	Ft.	in.	3/4	Copper	\$
				G. I.	
				C. I.	
				Pipe at	\$
	Nipples	in. at			\$
	Bushings	to in. at			\$
	Red'g Inc'g	Coupl'gs	to in. at		\$
	Union	in. at			\$
	Meter	in. at			\$
	Lead Joints	at			\$
	Compound Joints	at			\$
	Maintenance Foreman				\$
	Hrs. Water Maint. Man	1 at			\$
	Hrs. Water Maint. Man	2 at			\$
	Hrs. Garage Foreman	at			\$
	Hrs. Labor	at			\$
	Hrs. Compressor	at			\$
	Compensation Ins.	at \$		per C	\$
	Trucking				\$
	Pay't Patch				\$
	Tap by <i>Giordano Peterson</i>				\$
	<i>4-8-57</i>				\$
	O'head				\$

Lot-29V

-St-  
-Pl-  
Reservoir Dr. Ave. No. 10

Name of Owner  
*Coloney Homes*

Labor and Mat'l. Report *Apr. 8* 19*57*

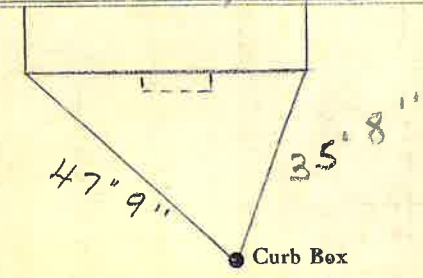

*Transite*  
6" Main

Elev. of Main at tap *5'*

Gate at • • Gate at

TAX ID # *302.17-4-12*

• Curb Box