

LABOR AND MATERIALS


_____	Copper } Connection _____	\$ _____
_____	Lead } _____	\$ _____
_____	Curb } Cock } _____ in.	\$ _____
	} Valve } _____	
	} T.S. & V. }	
_____	Service box { Short 3-1/2 x 4-1/2 }	\$ _____
_____	Old returned { Long 4-1/2 x 5-1/2 }	\$ _____
_____	Ft. _____ in. { Copper } Pipe at _____	\$ _____
	} G.I. }	
	} C.I. }	
_____	Nipples _____ in. at _____	\$ _____
_____	Bushings _____ to _____ in. at _____	\$ _____
_____	Red'g _____	\$ _____
_____	Inc'g _____	\$ _____
_____	Union _____ in. at _____	\$ _____
_____	Meter _____ in. at _____	\$ _____
_____	_____	\$ _____
_____	Compound Joints at _____	\$ _____
_____	Maintenance Foreman _____	\$ _____
_____	Hrs. Water Maint. Man - 1 at _____	\$ _____
_____	Hrs. Water Maint. Man - 2 at _____	\$ _____
_____	Hrs. Garage Foreman _____ at _____	\$ _____
_____	Hrs. Labor _____ at _____	\$ _____
_____	Hrs. Compressor at _____	\$ _____
_____	_____	\$ _____
_____	Trucking _____	\$ _____
_____	Pav't Patch _____	\$ _____
_____	_____	\$ _____
_____	_____	\$ _____
19 RIDGE

St
Pl.
Ave. No. _____

Name of Owner _____

Labor and Mat'l. Report 19

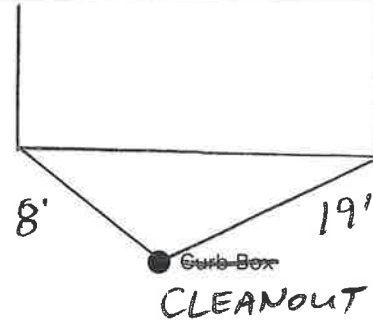

_____ Main

Elev. of
Main at tap _____

Gate at ●

● Gate at

TAX ID# 303.17-16-6

● Curb Box

RECEIVED

JAN 15 2018

**City of Glens Falls
W.W.T.P.**