

**Labor and Materials**

1	Copper	Connection	3/4"	\$	1.25
1	Lead			\$	
1	Curb	Cock Valve T.S.&V.	3/4" in	\$	1.70
1	Service Box	Short 3 1/2 x 4 1/2	}	\$	1.37
	Old returned	Long 4 1/2 x 5 1/2			
		Buff. or Ridway			
13	Ft.	3/4" in. { Copper Galv. Iron Cast Iron } Pipe at	13 1/2	\$	1.76
	Nipples	in. at		\$	
	Bushings	to in. at		\$	
	Red'g Inc'g	Couplings	to in. at	\$	
	Union	in. at		\$	
	Meter	in. at		\$	
	Lbs. Br. Stone	at		\$	
	Lbs. Sand	at		\$	
	Bags Cement	at		\$	
	Paving Brick	{ Mack Red Asphalt } at		\$	
	Lead Joints	at		\$	
	Leadite Joints	at		\$	
8	Hrs. Foreman	at	6.75	\$	5.-
3	Hrs. Common Labor	at	50	\$	1.50
15	Hrs. Common Labor	at	45	\$	6.75
	Hrs. Mason	at		\$	
	Hrs. Masons Helper	at		\$	
	Hrs. Compressor	at		\$	
	Compensation Ins			\$	.50
1	Trucking			\$	1.-
	Builders Use of Water			\$	
				Total	\$20.83


1935 -

Labor and Material Report

26

1935

36 ft. at 181 Ridge at 231

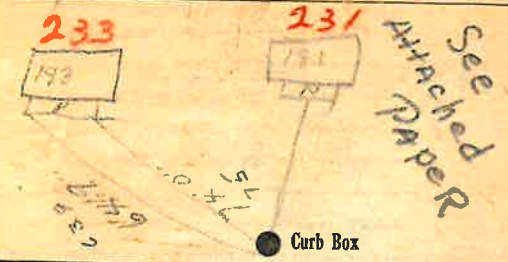

See Attached Paper

Main Elev. of Main at tap 411

Gate at TAX ID# 303.13-1-17 Gate at

Curb Box

Old top shut off at main  
Curb Box for 181 Ridge  
Measured from 183 Ridge  
Before Paving

3/4" - 13' COPPER

These MEASUREMENTS ARE FOR #231 & #233 Ridge St.

