

232
Labor and Material Report Nov 26 1925

182 Ridge St
NEW HOUSE



6 Main Elev. of Main at tap
Gate at ● Gate at ●


● Curb Box

3/4" - 27' COPPER

232 RIDGE Pl. Ave. No.

Name of Owner
TAX ID # 302.12-27-5

Labor and Mat'l. Report 19

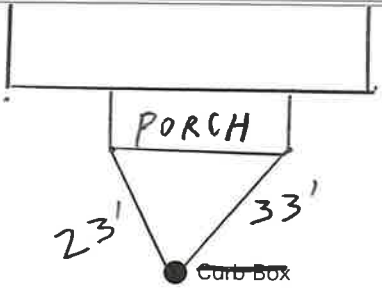

Main Elev. of Main at tap
Gate at ● Gate at ●

● Curb Box

RECEIVED

JAN 15 2018

**City of Glens Falls
W.W.T.P.**

Labor and Materials

7	Copper Lead	Connection.....	320
1	Curb	Cock Valve T.S. & V. } in.....	\$100
1	Service Box Old returned	Short 3 1/2 x 4 1/2 Long 4 1/2 x 5 1/2 Buff. or Rdway }	\$140
27	Ft. 3/4	Copper Galv. Iron Cast Iron } Pipe at.....	\$194
	Nipples.....	in. at.....	\$
	Bushings.....	to..... in. at.....	\$
1	Red'g Inc'g	Couplings } to..... in. at.....	\$
	Union.....	in. at.....	\$
	Meter.....	in. at.....	\$
	Lbs Br. Stone at.....		\$
	Lbs. Sand at.....		\$
	Bags Cement at.....		\$
	Paving Brick	{ Mack Red Asphalt } at.....	\$
	Lead Joints at.....		\$
	Leadite Joints at.....		\$
3	Hrs. Foreman at.....		\$
16	Hrs. Common Labor at.....		\$
	Hrs. Common Labor at.....		\$
	Hrs. Mason at.....		\$
	Hrs. Mason's Helper at.....		\$
2	Hrs. Compressor at.....		\$
	Compensation Ins.....		\$
8	Trucking.....		\$
8	Builders' Use of Water.....		\$
	Payment		
	Total	\$	2579

LABOR AND MATERIALS

_____	Copper } Connection _____	\$ _____
_____	Lead } _____	\$ _____
_____	Curb } Cock Valve } _____ in. _____	\$ _____
_____	} T.S. & V. } _____	\$ _____
_____	Service box { Short 3-1/2 x 4-1/2 } _____	\$ _____
_____	Old returned { Long 4-1/2 x 5-1/2 } _____	\$ _____
_____	Ft. _____ in. { Copper } Pipe at _____	\$ _____
_____	} G.I. } _____	\$ _____
_____	} C.I. } _____	\$ _____
_____	Nipples _____ in. at _____	\$ _____
_____	Bushings _____ to _____ in. at _____	\$ _____
_____	Red'g	\$ _____
_____	Inc'g	\$ _____
_____	Union _____ in. at _____	\$ _____
_____	Meter _____ in. at _____	\$ _____
_____	_____	\$ _____
_____	Compound Joints at _____	\$ _____
_____	Maintenance Foreman _____	\$ _____
_____	Hrs. Water Maint. Man - 1 at _____	\$ _____
_____	Hrs. Water Maint. Man - 2 at _____	\$ _____
_____	Hrs. Garage Foreman _____ at _____	\$ _____
_____	Hrs. Labor _____ at _____	\$ _____
_____	Hrs. Compressor at _____	\$ _____
_____	_____	\$ _____
_____	Trucking _____	\$ _____
_____	Pav't Patch _____	\$ _____
_____	_____	\$ _____
_____	_____	\$ _____
