

1935-88

233

Labor and Material Report *July 25* 19

3" tap at 110 Ridge st



● Curb Box

6" Main

Elev. of Main at tap *4.1*

Gate at ●

● Gate at

● Curb Box

*Old tap shut off at main
Before Paving*

MS


233 RIDGE

ST
Rl.
Ave. No.

Name of Owner

TAX ID # 303.13-1-18

Labor and Mat'l. Report 19

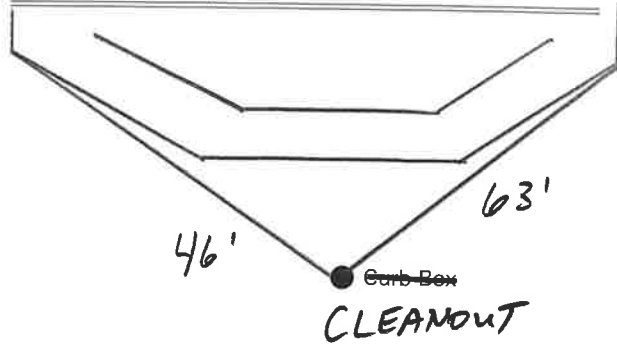

● Curb Box

CLEANOUT

Main

Elev. of Main at tap

Gate at ●

● Gate at

● Curb Box

RECEIVED

JAN 15 2018

City of Glens Falls
W.W.T.P.

