


LABOR AND MATERIALS

1	Copper	{ Connection	3/4"	\$ 2.76
	Lead			
1	Curb	{ Cock Valve	3/4 in.	\$ 3.49
		{ T.S. & V.		
1	Service box	{ Short 3 1/2 x 4 1/2		
	Old returned	{ Long 4 1/2 x 5 1/2		\$ 4.75
		{ Buff or Rdway		
7	Ft. 3/4 in.	{ Copper	Pipe at 35	\$ 2.45
		{ G.I.		
	Nipples	in. at		\$
	Bushings	to in. at		\$
	Red'g Inc'g	{ Coupl'gs to in. at		\$
	Union	in. at		\$
	Meter	in. at		\$
	Lead Joints at			\$
	Compound Joints at			\$
	Hrs. Water Maint. Man-1 at			\$
7	Hrs. Water Maint. Man-2 at	1.24	\$ 8.68	10
7	Hrs. Labor— at	1.13	\$ 7.91	11.50
	Hrs. Labor— at		\$	
	Hrs. Compressor at		\$	
	Compensation Ins. at \$37.06 per C.		\$ 61	
	Trucking		\$ 1.00	
	Pav't Patch		\$ 11.70	
			\$	
			\$	
			\$	
	O'head		\$	
	Tap by Gifford		\$ 43.35	
	4-30-52			

Ridge St. 251-259  
Ave. No.

Name of Owner  
John Goodrich

Labor and Mat'l. Report April 30 19 52

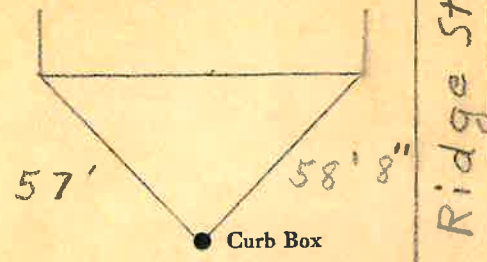

Raymond Ave.  
4" Main Elev. of Main at tap 4 1/2"

Gate at ● Gate at ●  
255-Tax ID # 303.9-10-13

● Curb Box  
Tap on Raymond Ave.  
3/4" - 7' Copper