

LABOR AND MATERIALS


1	Copper Lead	Connection	3/4	\$	1.31	
	Curb	Cock Valve T. S. & V.		in.	\$	
1	Service Box Old returned	Short 3 1/2 x 4 1/2 Long 4 1/2 x 5 1/2 Buff. or Rdway			\$ 1.60	
25	Ft. 3/4	Copper Galv. Iron Cast Iron	Pipe at 18		\$ 4.50	
	Nipples	in.	at		\$	
	Bushings	to	in.	at	\$	
	Red'g Inc'g	Couplings	to	in.	at	\$
	Union	in.	at		\$	
	Meter	in.	at		\$	
	Lead Joints	at			\$	
	Leadite Joints	at			\$	
	Hrs. Foreman	at			\$	
5	Hrs. Chauffeur	at	6 1/2		\$ 3.13	
6	Hrs. Tapper	at	2		\$ 3.75	
8	Hrs. Labor	at	45		\$ 3.60	
	Hrs. Labor	at			\$	
3	Hrs. Compressor	at	6 1/2		\$ 1.88	
	Compensation Ins.				\$.32	
	Trucking				\$ 1.-	
	Builders Use of Water	1/2 Patch (sewer)			\$ 2.50	
	Taphy Hassel				\$	
					\$	
					\$	
					\$	
					\$	
					\$ 23.59	

5 - - - 1940

St. 261
Pl. -
Ave. No. 199

Ridge
Name of Owner Top on Raymond Ave
Armstrong

Labor and Mat'l. Report Jan 5 1940

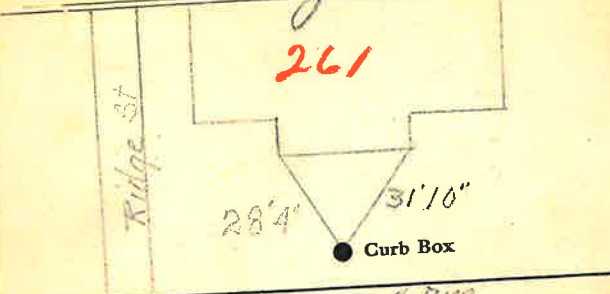

Elev. of Main at tap 5

Gate at ● Gate at ●

TAX ID # 303.9-9-12

● Curb Box

3/4" - 25' COPPER

Top on Raymond Ave
Near House