

262

Labor and Material Report Dec. 7. 1925

ont 206 Bridge St

Curb Box

6" Main Elev. of Main at tap 6'

Gate at ● ● Gate at


● Curb Box

3/4" - 26' copper

262 RIDGE. St.
 Ave. No. _____

Name of Owner
 TAX ID # 302.12-15-1

Labor and Mat'l. Report 19

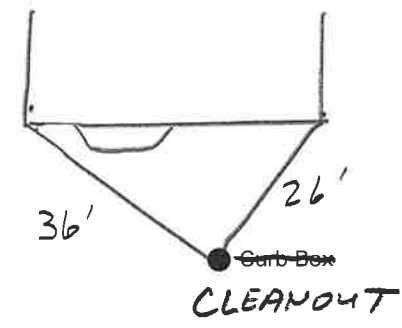

_____ Main Elev. of Main at tap _____

Gate at ● ● Gate at

● Curb Box

RECEIVED

JAN 15 2018

City of Glens Falls
 W.W.T.P.

