


264 RIDGE

St. Pl. Ave. No.

Name of Owner

TAX ID # 302.12-15-2

Labor and Mat'l. Report 19

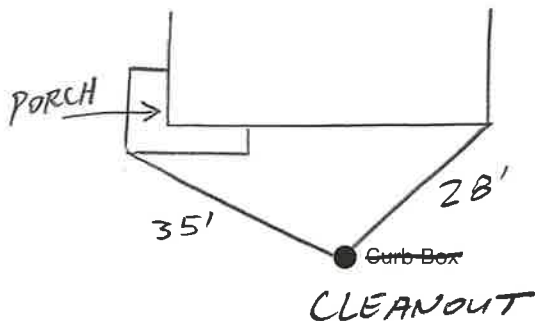

_____ Main Elev. of Main at tap _____
 Gate at ● Gate at ●

 ● Curb Box

RECEIVED

JAN 15 2018


**City of Glens Falls
W.W.T.P.**

Ridge

St. Pl. Ave. No. 264

Name of Owner

Measured in Oct 16-64.
Labor and Mat'l. Report 19 27

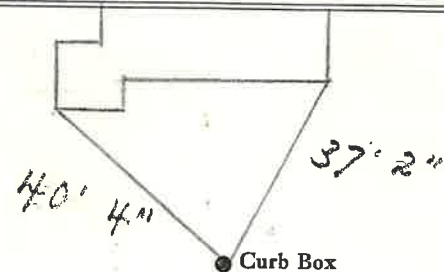

_____ Main Elev. of Main at tap 5'
 Gate at ● Gate at ●

 ● Curb Box

3/4" - 24' COPPER

