


265 RIDGE St. Pl. Ave. No.

Name of Owner TAX ID # 303.9-9-11

Labor and Mat'l. Report 19

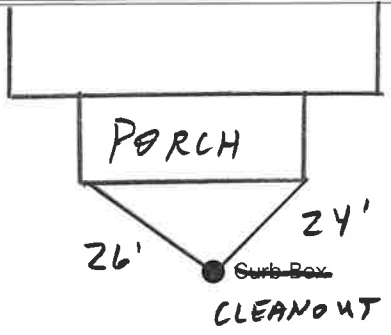

Main Elev. of Main at tap Gate at Curb Box

RECEIVED JAN 15 2018 City of Glens Falls W.W.T.P.

Ridge St. Pl. Ave. No. 265-203

Name of Owner O'Connor

Measured in Labor and Mat'l. Report Jan. 26 1938



Main Elev. of Main at tap Gate at Curb Box

LABOR AND MATERIALS

_____ Copper } Connection _____ \$ _____
 _____ Lead }
 _____ Curb } Cock } _____ in. \$ _____
 _____ Valve }
 _____ T.S. & V. }
 _____ Service box { Short 3-1/2 x 4-1/2 } _____ \$ _____
 _____ Old returned { Long 4-1/2 x 5-1/2 }
 _____ Ft. _____ in. { Copper } Pipe at _____ \$ _____
 _____ { G.I. }
 _____ { C.I. }
 _____ Nipples _____ in. at _____ \$ _____
 _____ Bushings _____ to _____ in. at _____ \$ _____
 _____ Red'g _____
 _____ Inc'g _____
 _____ Union _____ in. at _____ \$ _____
 _____ Meter _____ in. at _____ \$ _____
 _____ \$ _____
 _____ Compound Joints at _____ \$ _____
 _____ Maintenance Foreman _____ \$ _____
 _____ Hrs. Water Maint. Man - 1 at _____ \$ _____
 _____ Hrs. Water Maint. Man - 2 at _____ \$ _____
 _____ Hrs. Garage Foreman _____ at _____ \$ _____
 _____ Hrs. Labor _____ at _____ \$ _____
 _____ Hrs. Compressor at _____ \$ _____
 _____ \$ _____
 _____ Trucking _____ \$ _____
 _____ Pav't Patch _____ \$ _____
 _____ \$ _____
 _____ \$ _____
Labor and Materials

_____ Copper } Connection..... \$ _____
 _____ Lead }
 _____ Curb } Cock } _____ in. \$ _____
 _____ Valve }
 _____ T. S. & V. }
 _____ Service Box { Short 3 1/2 x 4 1/2 } _____ \$ _____
 _____ Old returned { Long 4 1/2 x 5 1/2 }
 _____ { Buff. or Rdway }
 _____ Ft. _____ in. { Copper } Pipe at _____ \$ _____
 _____ { Galv Iron }
 _____ { Cast Iron }
 _____ Nipples _____ in. at _____ \$ _____
 _____ Bushings _____ to _____ in. at _____ \$ _____
 _____ Red'g } Conplings.....to.....in. at _____ \$ _____
 _____ Inc'g }
 _____ Union..... in. at _____ \$ _____
 _____ Meter.....in. at _____ \$ _____
 _____ Lead Joints at _____ \$ _____
 _____ Leadite Joints at _____ \$ _____
 _____ Hrs. Foreman at _____ \$ _____
 _____ Hrs. Chauffeur at _____ \$ _____
 _____ Hrs. Tapper at _____ \$ _____
 _____ Hrs. Labor at _____ \$ _____
 _____ Hrs. Labor at _____ \$ _____
 _____ Hrs. Compressor at _____ \$ _____
 _____ Compensation Ins. _____ \$ _____
 _____ Trucking _____ \$ _____
 _____ Builders Use of Water _____ \$ _____
 _____ \$ _____
 _____ \$ _____
