

268 RIDGE

St.


Pl.

Ave. No.

Name of Owner

TAX ID # 302.12-15-4

Labor and Mat'l. Report 19

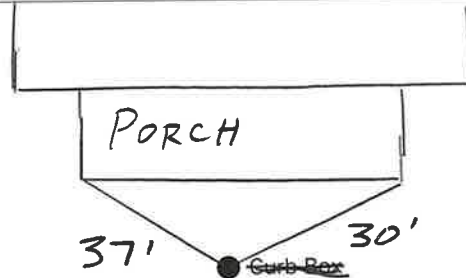

CLEANOUT

Main

Elev. of Main at tap

Gate at

Gate at

Curb Box

**RECEIVED**

**JAN 15 2018**

**City of Glens Falls  
W.W.T.P.**

30-164

268

Labor and Material Report

11-14-

19

# 212 Ridge H



Curb Box

6

Main

Elev. of Main at tap

Gate at

Gate at

Curb Box

Old tap Dike

31' to MAIN

