


Labor and Materials

1	Copper } Connection	$\frac{3}{4}$	\$ 3.20
	Lead			
1	Curb } Cock		\$ 1.00
	Valve			
	T.S. & V.			
1	Service Box } Short 3' x 4'		\$ 1.40
	Old returned } Long 4' x 5'			
9	Ft. $\frac{3}{4}$ in. } Copper		\$ 1.98
	Nipples		\$
	Bushings		\$
	Red'g } Couplings		\$
	Inc'g			
	Union		\$
	Meter		\$
	Lbs. Br. Stone		\$
	Lbs. Sand		\$
	Bags Cement		\$
	Paving Brick } Mack		\$
	Lead Joints		\$
	Leadite Joints		\$
2	Hrs. Foreman	62.5	\$ 12.5
2	Hrs. Common Labor	50	\$ 10.0
8	Hrs. Common Labor	40.5	\$ 8.1
	Hrs. Mason		\$
	Hrs. Mason's Helper		\$
	Hrs. Compressor		\$
	Compensation Ins.		\$ 1.6
	Trucking		\$ 1.00
	Builders' Use of Water		\$
Total				\$ 14.24

26-169 269

Labor and Material Report Oct, 29 1926

202 11 Bridge St

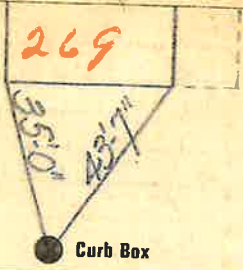

6" Main Elev. of Main at tap 6'
 Gate at TAX ID # 3039-9-9 Gate at

Curb Box

new house

$\frac{3}{4}$ " - 9' COPPER