

272
Labor and Material Report 9/18/1985

2.16 Ridge St.

2.16
272
 30'
 40'
 Curb Box

OUTSIDE CLEANOUT 1' SW OF CURB BOX

Main Elev. of Main at tap 4 1/2


Gate at 27' COPPER Gate at

NEW TAP PUT IN 6/30/81
 Old tap disconnected.
 Same measurement

272 RIDGE St Pl. Ave. No.

Name of Owner
 TAX ID # 302.12-15-6

Labor and Mat'l. Report 19

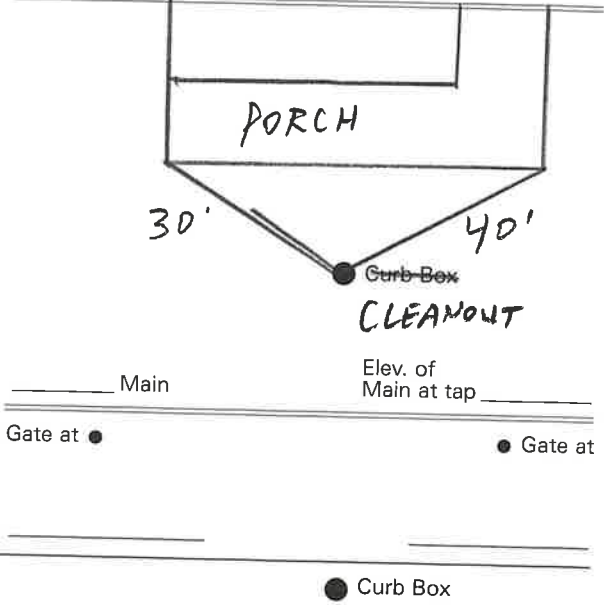

RECEIVED

JAN 15 2018

**City of Glens Falls
 W.W.T.P.**

