



273 RIDGE

Pl. Ave.-No.

Name of Owner

TAX ID # 303.9-6-17

Labor and Mat'l. Report 19

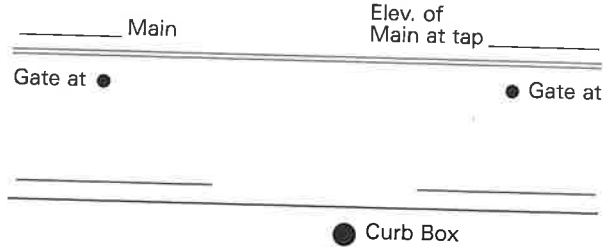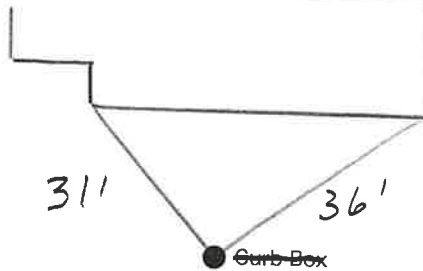

RECEIVED

JAN 15 2018


City of Glens Falls W.W.T.P.

1935-19 ~~267~~ 273

Labor and Material Report


May 6 1935

213 Ridge St

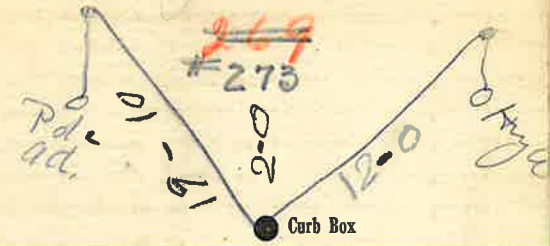

6 Main Elev. of Main at tap 5

Gate at Gate at

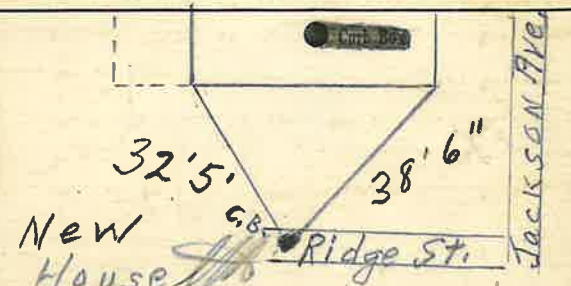

House faces #2 Jackson Tap on Ridge St. 3/4" - 10' COPPER

LABOR AND MATERIALS

_____	Copper } Connection _____	\$ _____
_____	Lead } _____	\$ _____
_____	Curb } Cock } _____ in.	\$ _____

_____	Service box { Short 3-1/2 x 4-1/2 } _____	\$ _____
_____	Old returned { Long 4-1/2 x 5-1/2 } _____	\$ _____
_____	Ft. _____ in. { Copper } Pipe at _____	\$ _____

_____	Nipples _____ in. at _____	\$ _____
_____	Bushings _____ to _____ in. at _____	\$ _____
_____	Red'g _____	\$ _____
_____	Inc'g _____	\$ _____
_____	Union _____ in. at _____	\$ _____
_____	Meter _____ in. at _____	\$ _____
_____	_____	\$ _____
_____	Compound Joints at _____	\$ _____
_____	Maintenance Foreman _____	\$ _____
_____	Hrs. Water Maint. Man - 1 at _____	\$ _____
_____	Hrs. Water Maint. Man - 2 at _____	\$ _____
_____	Hrs. Garage Foreman _____ at _____	\$ _____
_____	Hrs. Labor _____ at _____	\$ _____
_____	Hrs. Compressor at _____	\$ _____
_____	_____	\$ _____
_____	Trucking _____	\$ _____
_____	Pav't Patch _____	\$ _____
_____	_____	\$ _____
_____	_____	\$ _____
Labor and Materials

_____	Copper } Connection ^{3/4} _____	\$ 1.75
_____	Lead } _____	\$ _____
_____	Curb } Cock } ^{3/4} in. _____	\$ 1.70

_____	Service Box { Short 3 1/2 x 4 1/2 } _____	\$ 1.45
	Old returned { Long 4 1/2 x 5 1/2 } _____	\$ _____
_____	10 Ft. ^{3/4} in. { Copper } Pipe at 13 1/2	\$ 1.35

_____	Nipples _____ in. at _____	\$ _____
_____	Bushings _____ to _____ in. at _____	\$ _____
_____	Red'g } Couplings _____ to _____ in. at _____	\$ _____
	Inc'g } _____	\$ _____
_____	Union _____ in. at _____	\$ _____
_____	Meter _____ in. at _____	\$ _____
_____	Lbs. Br. Stone at _____	\$ _____
_____	Lbs. Sand at _____	\$ _____
_____	Bags Cement at _____	\$ _____
_____	Paving Brick { Mack } at _____	\$ _____

_____	Lead Joints at _____	\$ _____
_____	Leadite Joints at _____	\$ _____
_____	2 Hrs. Foreman at ^{6 1/2} _____	\$ 1.25
_____	7 Hrs. Common Labor at ^{4.5} _____	\$ 3.15
_____	Hrs. Common Labor at _____	\$ _____
_____	Hrs. Mason at _____	\$ _____
_____	Hrs. Masons Helper at _____	\$ _____
_____	Hrs. Compressor at _____	\$ _____
_____	Compensation Ins _____	\$ 1.16
_____	Trucking _____	\$ 1.50
_____	Builders Use of Water Patch _____	\$ 2.50

Total \$ 13.91