
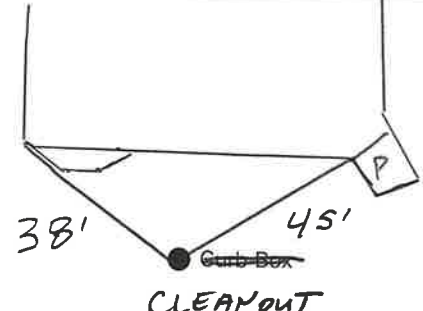


31-81 **277** July 15 1931  
 Labor and Material Report  
 215 Ridge St 3/4 tap  
  
 6<sup>41</sup> Main Elev of Main at tap 4.6  
 Gate at ● Gate at ●  
 ● Curb Box  
 Old tap shut off  
 3/4" - 12' COPPER

**277 RIDGE** SD  
 Pl. Ave. No. \_\_\_\_\_  
 Name of Owner \_\_\_\_\_  
 TAX ID # 303.9-6-16  
 Labor and Mat'l. Report 19  
  
 Main Elev. of Main at tap \_\_\_\_\_  
 Gate at ● Gate at ●  
 ● Curb Box

**RECEIVED**

**JAN 15 2018**

**City of Glens Falls  
 W.W.T.P.**

