


274 RIDGE

St.
Pl.
Ave. No.

Name of Owner

Labor and Mat'l. Report 19

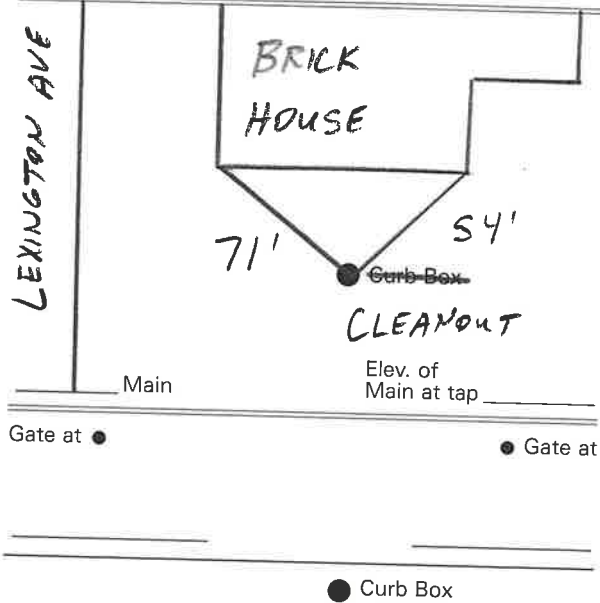

RECEIVED

JAN 15 2018

**City of Glens Falls
W.W.T.P.**

22 - no 274 on map

ur and Material Report 19

218 Ridge St.

278

2 Curb boxes ● Curb Box

TAX ID# 303.95-1

6" Main Elev. of Main at tap 6 1/2

Gate at ● Gate at

● Curb Box

3/4" = 50' COPPER

A hand-drawn utility diagram on a grid background, similar to the one on the left. It shows a 'Main' line with a 'Curb Box' and a 'CLEANOUT'. Dimensions include '71'' and '54''. Above the cleanout is a 'BRICK HOUSE'. The diagram is annotated with handwritten notes: '218 Ridge St.', '278' in red, '2 Curb boxes ● Curb Box', 'TAX ID# 303.95-1', '6" Main', 'Elev. of Main at tap 6 1/2', and '3/4" = 50' COPPER'. There are also 'Gate at' markers and a 'Curb Box' marker at the bottom.

