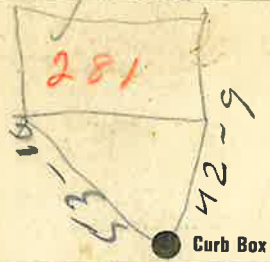
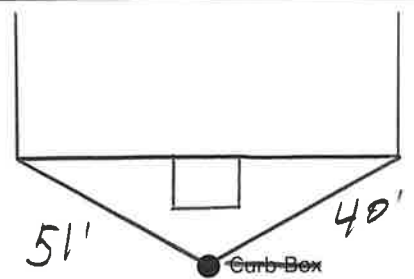


134 281
 Labor and Material Report Oct 1 1925
219 Ridge St

 12" Main
 Elev of Main at tap 5
 Gate at ● Gate at ●
 ● Curb Box
 New Hours -

281 RIDGE St.
 Pl. Ave. No. _____

Name of Owner
 TAX ID # 303.9-6-15

Labor and Mat'l. Report 19 _____



CLEANOUT

Main Elev. of Main at tap _____
 Gate at ● Gate at ●

● Curb Box
RECEIVED
 JAN 15 2018
 City of Glens Falls
 W.W.T.P.

Labor and Materials

Copper } Connection	3	20
Lead } Connection		
Curb } Cock Valve T.S. & V. } in.	4	00
Service Box } Short 3 1/2 x 4 1/2 } Old returned } Long 4 1/2 x 5 1/2 } } (for Redway)	4	00
9 Ft. in. } Copper Galv. Iron } Pipe at		242
Cast Iron }		
Nipples in. at		
Bushings to in. at		
Red'g } Couplings to in. at		
Inc'g }		
Union in. at		
Meter in. at		
Lbs. Br. Stone at		
Lbs. Sand at		
Bags Cement at		
Paving Brick } Mack } } Red } } Asphalt }		
Lead Joints at		
Leadite Joints at		
1 Hrs. Foreman at		1.25
7 Hrs. Common Labor at		2.84
Hrs. Common Labor at		
Hrs. Mason at		
Hrs. Mason's Helper at		
Hrs. Compressor at		
Compensation Ins		11
Trucking		1.00
Builders' Use of Water		
Total \$		13.12

LABOR AND MATERIALS

Copper } Connection		\$
Lead } Connection		\$
Curb } Cock Valve T.S. & V. } in.		\$
Service box } Short 3-1/2 x 4-1/2 } Old returned } Long 4-1/2 x 5-1/2 }		\$
Ft. in. } Copper G.I. } Pipe at		\$
C.I. }		
Nipples in. at		\$
Bushings to in. at		\$
Red'g		
Inc'g		
Union in. at		\$
Meter in. at		\$
		\$
Compound Joints at		\$
Maintenance Foreman		\$
Hrs. Water Maint. Man - 1 at		\$
Hrs. Water Maint. Man - 2 at		\$
Hrs. Garage Foreman at		\$
Hrs. Labor at		\$
Hrs. Compressor at		\$
		\$
Trucking		\$
Pav't Patch		\$
		\$
		\$
LABOR AND MATERIALS

1	Copper	{	Connection	1" in.		\$
	Lead					
1	Curb	{	Cock Valve	1" in.	\$ 5.19	
			T. S. & V.			
1	Service box	{	Short 3 1/2 x 4 1/2		\$ 4.25	
	Old returned		Long 4 1/2 x 5 1/2			
			Buff or Rdway			
23	Ft. 1" in.	{	Copper	Pipe at 40	\$ 9.20	
			G. I.			
			C. I.			
	Nipples		in. at		\$	
	Bushings		to in. at		\$	
	Red'g	{	Coupl'gs	to in. at	\$	
	Inc'g					
	Union		in. at		\$	
	Meter		in. at		\$	
	Lead Joints		at		\$	
	Compound Joints		at		\$	
1	Hrs. Water Maint. Man		1 at 1.12	\$ 1.12		
14	Hrs. Water Maint. Man		2 at 1.02	\$ 14.28		
	Hrs. Labor		at	\$		
12	Hrs. Labor		at 91	\$ 10.92		
5	Hrs. Compressor		at 1.20	\$ 6.00		
	Compensation Ins.		at \$ 2.226 per C.	\$ 1.59		
	Trucking			\$ 1.59		
	Pav't Patch			\$ 25.88		
	10 1/4" Main			\$		
				\$		
				\$		
	O'head			\$		
				\$		

41-1530

St.
Pl.
Ave. No. 281

Ridge


Name of Owner

Maail Green House

Labor and Mat'l. Report

Apr 28

1950

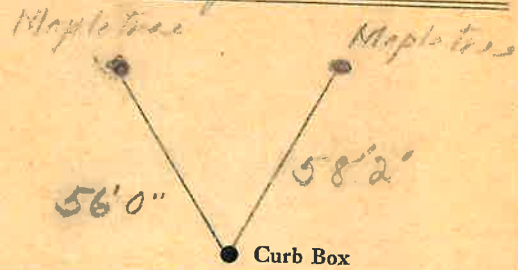

6 Main

Elev. of Main at tap 5

Gate at ●

● Gate at

● Curb Box

1" Tap.
23' to main

This tap is on Sagamore