

283
 Labor and Material Report *Def 2* 1923

221 Ridge St T
283 NEW TAP
 Tel. a. Pal NO HOUSE
 see below
 15' 6" Curb Box

6" Main Elev. of Main at tap 6'
 Gate at ● 15' COPPER ● Gate at


Curb Box
 11' 6" 11' 6"

283 RIDGE

Pl. Ave. No. _____

Name of Owner _____
 TAX ID # 303.9-6-14

Labor and Mat'l. Report 19

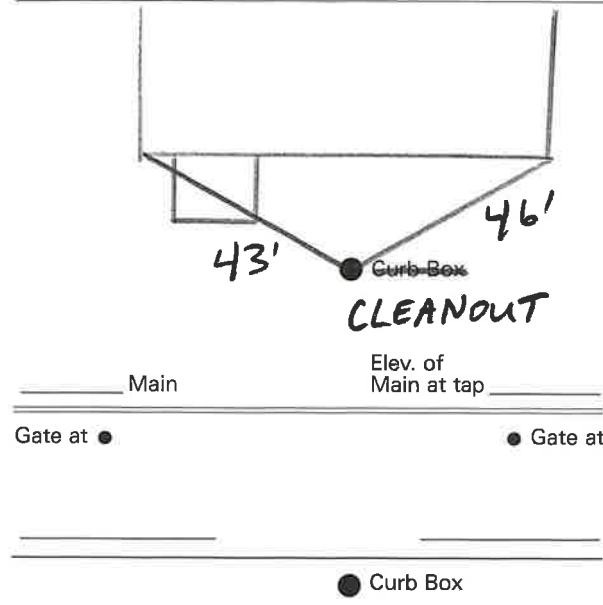

RECEIVED
JAN 15 2018
 City of Glens Falls
 W.W.T.P.

283

Labor and Material Report

Oct 12 1923

921 B-184 T

283 NEW TAP

for Park NO HOUSE

see

curb box below



Main

Elev. of Main at tap


10'

Gate at

15' copper

Gate at

Curb Box

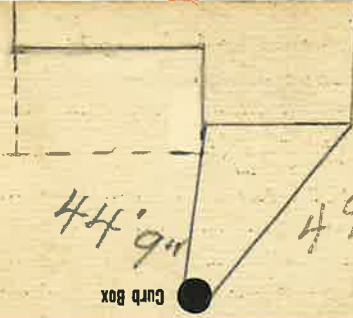

Labor and Materials

1	Lead Connection	12°	\$
1	Curb Cock	3/4	\$
1	Service Box	{ Short 3 1/2 x 4 1/2 Long 4 1/2 x 5 1/2 Buffalo	\$
14	Ft. in. G. I. Pipe at	3/4	\$
	Nipples	in. at	\$
	Bushings	in. at	\$
	Red'g Coup	to in. at	\$
	Inc'g Coup	to in. at	\$
	Union	in. at	\$
	Meter	in. at	\$
	Cu. Yds. Br. Stone at		\$
	Cu. Yds. Sand at		\$
	Bags Cement at		\$
	Pav. Brick	{ Mack Red Asphalt } at	\$
8	Hrs. Foreman at		\$
8	Hrs. Com. Labor at		\$
	Hrs. Mason at		\$
	Hrs.	at	\$
	Hrs.	at	\$
90	Builders' Use of Water		\$
	TRUCK	1.00	\$
			\$
			\$
			\$
14	Total	\$	157.33

Labor and Material Report

283

1922

7 1/2" tap at 22.1 Ridge

No measurement for box

Curb Box

6 Main

Elev. of Main at tap 6 1/2'

Gate at

Gate at

Curb Box