


290 RIDGE

Pl. Ave. No.

Name of Owner

TAX ID # 303.9-5-4

Labor and Mat'l. Report 19

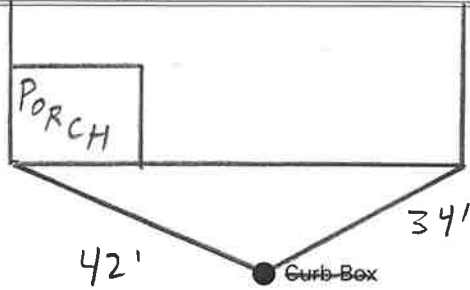

Main

Elev. of Main at tap

Gate at ●

● Gate at

● Curb Box

RECEIVED

JAN 15 2018


City of Glens Falls
W.W.T.P.

290

Labor and Material Report

1926

3/4" top of Lot 230 Copper Ridge

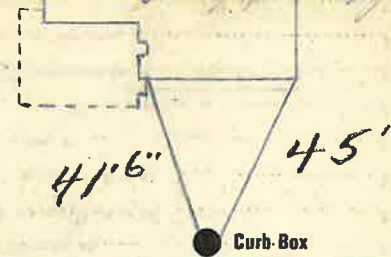

● Curb-Box

Main

Elev. of Main at tap

Gate at ●

● Gate at

● Curb Box

3/4" - 26' COPPER

LABOR AND MATERIALS

_____	Copper } Connection _____	\$ _____
_____	Lead } _____	\$ _____
_____	Curb } Cock Valve } _____ in.	\$ _____
_____	_____ } T.S. & V. } _____	\$ _____
_____	Service box { Short 3-1/2 x 4-1/2 } _____	\$ _____
_____	Old returned { Long 4-1/2 x 5-1/2 } _____	\$ _____
_____	Ft. _____ in. { Copper } Pipe at _____	\$ _____
_____	_____ } G.I. } _____	\$ _____
_____	_____ } C.I. } _____	\$ _____
_____	Nipples _____ in. at _____	\$ _____
_____	Bushings _____ to _____ in. at _____	\$ _____
_____	Red'g _____	\$ _____
_____	Inc'g _____	\$ _____
_____	Union _____ in. at _____	\$ _____
_____	Meter _____ in. at _____	\$ _____
_____	_____	\$ _____
_____	Compound Joints at _____	\$ _____
_____	Maintenance Foreman _____	\$ _____
_____	Hrs. Water Maint. Man - 1 at _____	\$ _____
_____	Hrs. Water Maint. Man - 2 at _____	\$ _____
_____	Hrs. Garage Foreman _____ at _____	\$ _____
_____	Hrs. Labor _____ at _____	\$ _____
_____	Hrs. Compressor at _____	\$ _____
_____	_____	\$ _____
_____	Trucking _____	\$ _____
_____	Pav't Patch _____	\$ _____
_____	_____	\$ _____
_____	_____	\$ _____
Labor and Materials		
1	Copper } Connection <u>3/4"</u>	\$ 3.20
1	Lead } _____	\$ _____
1	Curb } Cock Valve } _____ in.	\$ 1.00
1	_____ } T.S. & V. } _____	\$ _____
1	Service Box { Short 3 x 4 } _____	\$ 1.40
1	Old returned { Long 4 1/2 x 5 1/2 } _____	\$ _____
26	Ft. <u>3/4"</u> in. { Copper } Pipe at _____	\$ 5.72
	_____ } Galv. Iron } _____	\$ _____
	_____ } Cast Iron } _____	\$ _____
	Nipples _____ in. at _____	\$ _____
	Bushings _____ to _____ in. at _____	\$ _____
1	Red'g } Couplings <u>3/4" Brass</u>	\$ 1.50
1	Inc'g } _____ to _____ in. at _____	\$ _____
	Union _____ in. at _____	\$ _____
	Meter _____ in. at _____	\$ _____
	Lbs. Br. Stone at _____	\$ _____
	Lbs. Sand at _____	\$ _____
	Bags Cement at _____	\$ _____
	Paving Brick { Mack } at _____	\$ _____
	_____ } Red } _____	\$ _____
	_____ } Asphalt } _____	\$ _____
	Lead Joints at _____	\$ _____
	Leadite Joints at _____	\$ _____
15	Hrs. Foreman at <u>5.95</u>	\$ 9.38
24	Hrs. Common Labor at <u>40%</u>	\$ 9.75
	Hrs. Common Labor at _____	\$ 9.75
	Hrs. Mason at _____	\$ _____
	Hrs. Mason's Helper at _____	\$ _____
	Hrs. Compressor at _____	\$ _____
	Compensation Ins. _____	\$ 51
	Trucking _____	\$ 1.00
	Builders' Use of Water _____	\$ _____
Total		\$ 32.09