

291 RIDGE




Fr. Ave. No. _____

Name of Owner _____

TAX ID # 303.9-6-10

Labor and Mat'l. Report 19 _____

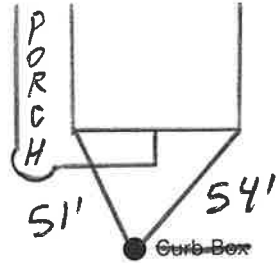

CLEANOUT

_____ Main Elev. of Main at tap _____

Gate at ● Gate at ●

● Curb Box

RECEIVED

JAN 15 2018


**City of Glens Falls
W.W.T.P.**

291
Labor and Material Report

July 27

1931

229 Ridge St. 3/4" tap

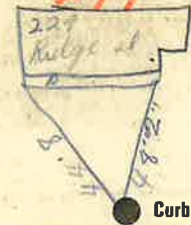

Curb Box

6" Main

Elev of Main at tap 4.6'

Gate at ●

Gate at ●

● Curb Box

Old tap shut off

3/4" - 10' COPPER

LABOR AND MATERIALS

_____	Copper } Connection _____	\$ _____
_____	Lead } _____	\$ _____
_____	Curb } Cock } _____ in. _____	\$ _____
	} Valve } _____	
	} T.S. & V. } _____	
_____	Service box { Short 3-1/2 x 4-1/2 } _____	\$ _____
_____	Old returned { Long 4-1/2 x 5-1/2 } _____	\$ _____
_____	Ft. _____ in. { Copper } Pipe at _____	\$ _____
	} G.I. } _____	
	} C.I. } _____	
_____	Nipples _____ in. at _____	\$ _____
_____	Bushings _____ to _____ in. at _____	\$ _____
_____	Red'g _____	\$ _____
_____	Inc'g _____	\$ _____
_____	Union _____ in. at _____	\$ _____
_____	Meter _____ in. at _____	\$ _____
_____	_____	\$ _____
_____	Compound Joints at _____	\$ _____
_____	Maintenance Foreman _____	\$ _____
_____	Hrs. Water Maint. Man - 1 at _____	\$ _____
_____	Hrs. Water Maint. Man - 2 at _____	\$ _____
_____	Hrs. Garage Foreman _____ at _____	\$ _____
_____	Hrs. Labor _____ at _____	\$ _____
_____	Hrs. Compressor at _____	\$ _____
_____	_____	\$ _____
_____	Trucking _____	\$ _____
_____	Pav't Patch _____	\$ _____
_____	_____	\$ _____
_____	_____	\$ _____
Labor and Materials

1	Copper } Connection 3/4"	\$ 2.60
	Lead } _____	
1	Curb } Cock } 3/4" in. _____	\$ 2.27
	} Valve } _____	
	} T.S. & V. } _____	
1	Service Box { Short 3 1/2 x 4 1/2 } _____	\$ 1.08
	Old returned { Long 4 1/2 x 5 1/2 } _____	
	} Buff. or Rdway } _____	
10	Ft. 3/4 in. { Copper } Pipe at _____	\$ 1.80
	} Galv. Iron } _____	
	} Cast Iron } _____	
_____	Nipples _____ in. at _____	\$ _____
_____	Bushings _____ to _____ in. at _____	\$ _____
_____	Red'g } Couplings _____ to _____ in. at _____	\$ _____
	Inc'g } _____	
_____	Union _____ in. at _____	\$ _____
_____	Meter _____ in. at _____	\$ _____
_____	Lbs. Br. Stone at _____	\$ _____
_____	Lbs. Sand at _____	\$ _____
_____	Bags Cement at _____	\$ _____
_____	Paving Brick { Mack } at _____	\$ _____
	} Red } _____	
	} Asphalt } _____	
_____	Lead Joints at _____	\$ _____
_____	Leadite Joints at _____	\$ _____
7	Hrs. Foreman at _____	\$ 1.25
16	Hrs. Common Labor at _____	\$ 7.20
_____	Hrs. Common Labor at _____	\$ _____
_____	Hrs. Mason at _____	\$ _____
_____	Hrs. Mason's Helper at _____	\$ _____
_____	Hrs. Compressor at _____	\$ _____
_____	Compensation Ins _____	\$ 2.6
_____	Trucking _____	\$ 1.00
_____	Builders' Use of Water Patch _____	\$ 5.00
Total \$		27.6