

293 RIDGE

St


Pl.

Ave. No.

Name of Owner

TAX ID # 303.9-6-9.2

Labor and Mat'l. Report 19

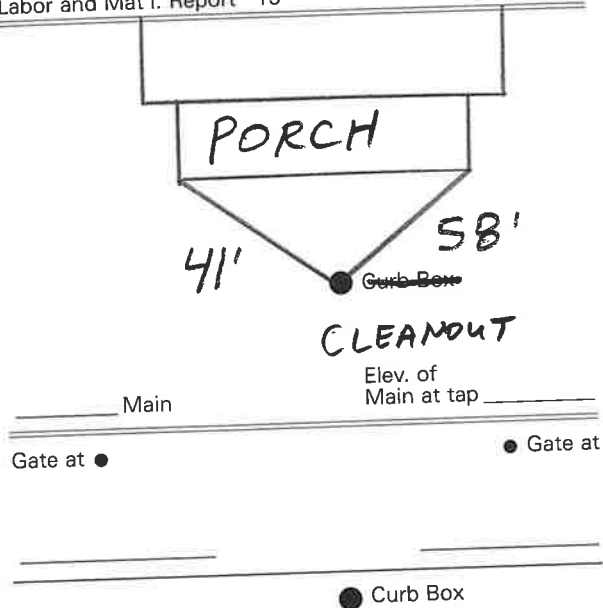

RECEIVED

JAN 15 2018

City of Glens Falls
W.W.T.P.

26-106 293

Labor and Material Report Aug 9 1916

No 231 Bridge st.

6' Main Elev. of Main at tap 6

Gate at Gate at

Curb Box

3/4" - 11' COPPER

LABOR AND MATERIALS

<u> </u>	Copper } Connection	<u> </u>	\$	<u> </u>
<u> </u>	Lead } <u> </u>		\$	<u> </u>
<u> </u>	Curb } Cock Valve } <u> </u> in.		\$	<u> </u>
				<u> </u>
<u> </u>	Service box } Short 3-1/2 x 4-1/2		\$	<u> </u>
	Old returned } Long 4-1/2 x 5-1/2		\$	<u> </u>
<u> </u>	Ft. <u> </u> in. } Copper } Pipe at		\$	<u> </u>
				<u> </u>
<u> </u>	Nipples <u> </u> in. at		\$	<u> </u>
<u> </u>	Bushings <u> </u> to <u> </u> in. at		\$	<u> </u>
<u> </u>	Red'g			<u> </u>
<u> </u>	Inc'g			<u> </u>
<u> </u>	Union <u> </u> in. at		\$	<u> </u>
<u> </u>	Meter <u> </u> in. at		\$	<u> </u>
<u> </u>			\$	<u> </u>
<u> </u>	Compound Joints at		\$	<u> </u>
<u> </u>	Maintenance Foreman		\$	<u> </u>
<u> </u>	Hrs. Water Maint. Man - 1 at		\$	<u> </u>
<u> </u>	Hrs. Water Maint. Man - 2 at		\$	<u> </u>
<u> </u>	Hrs. Garage Foreman <u> </u> at		\$	<u> </u>
<u> </u>	Hrs. Labor <u> </u> at		\$	<u> </u>
<u> </u>	Hrs. Compressor at		\$	<u> </u>
<u> </u>			\$	<u> </u>
<u> </u>	Trucking		\$	<u> </u>
<u> </u>	Pav't Patch		\$	<u> </u>
<u> </u>			\$	<u> </u>
<u> </u>			\$	<u> </u>
Labor and Materials			
1	Copper } Connection	3.4	\$ 320
1	Curb } Cock Valve } T.S. & V. } <u> </u> in.		\$ 100
	Service Box } Short 3 1/2 x 4 1/2		\$ 130
	Old returned } Long 4 1/2 x 5 1/2		\$
			Buff. or Rdway
1 1/2	Ft. <u> </u> in. } Copper } Galv. Iron } Cast Iron } Pipe at		\$ 242
	Nipples <u> </u> in. at		\$
	Bushings <u> </u> to <u> </u> in. at		\$
	Red'g } Inc'g } Couplings		\$
	Union <u> </u> in. at		\$
	Meter <u> </u> in. at		\$
	Lbs. Br. Stone at		\$
	Lbs. Sand at		\$
	Bags Cement at		\$
	Paving Brick } Mack } Red } Asphalt } at		\$
	Lead Joints at		\$
	Leadite Joints at		\$
5	Hrs. Foreman at	6.25	\$ 312
14	Hrs. Common Labor at	50	\$ 700
	Hrs. Common Labor at		\$
	Hrs. Mason at		\$
	Hrs. Mason's Helper at		\$
	Hrs. Compressor at		\$
	Compensation Ins.		\$ 27
	Trucking		\$ 100
	Builders' Use of Water		\$
Total			\$ 1931