


LABOR AND MATERIALS

1	Copper	} Connection ^{3/4"}	\$
1	Lead		\$
1	Curb	} Cock Valve ^{3/4" in.} T. S. & V. } Or seat	\$
1	Service box		} Short 3 1/2 x 4 1/2 Long 4 1/2 x 5 1/2 Buff or Rdway }
28	Ft. ^{3/4" in.}	} Copper G.I. G.I. }	
	Nipples		in. at \$
	Bushings	to in. at \$	
	Red'g } Inc'g }	Coupl'gs to in. at \$	
	Union	in. at \$	
	Meter	in. at \$	
	Lead Joints	at \$	
	Compound Joints	at \$	
	Maintenance Foreman	\$	
	Hrs. Water Maint. Man-1	at \$	
	Hrs. Water Maint. Man-2	at \$	
	Hrs. Garage Foreman	at \$	
	Hrs. Labor	at \$	
	Hrs. Compressor	at \$	
	Compensation Ins. at \$	per C \$	
	Trucking	\$	
	Pav't Patch	\$	
	Tap by Larcrau Peck & Co	\$	
	6-4-71	\$	
	O'head	\$	
		\$	

Ridge St. Pl. No. 296 Ave. No.

Name of Owner Portia Bishop

Labor and Mat'l. Report June 4 19 71

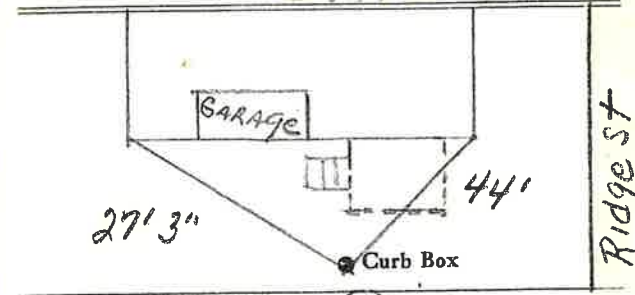

MACARTHUR DRIVE
Elev. of Main at tap 4'
12" Main

Gate at • Gate at

TAX ID # 303.9-4-1

• Curb Box

3/4" - 28' COPPER

LSM-5C-6-1-67

TAP ON MACARTHUR DR.