


297 RIDGE

St.  
Pl.  
Ave. No.

Name of Owner

TAX ID # 303.9-6-8

Labor and Mat'l. Report 19

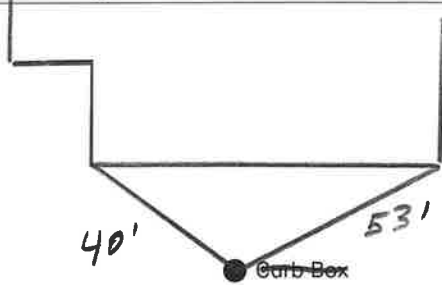

CLEANOUT

Main Elev. of Main at tap

Gate at ● Gate at ●

● Curb Box

RECEIVED

JAN 15 2018

City of Glens Falls  
W.W.T.P.

✓

Ridge St.  
Pl. Ave. No. 297

Name of Owner Duncanson  
Monica Stack

Labor and Mat'l. Report May 19 1959

39' 10"  
Try 38' 5"  
51' 2"  
50' 4"  
● Curb Box

6" Main Elev. of Main at tap 6 1/2'

Gate at ● Gate at ●

● Curb Box

3/4" - 12' COPPER

LSM-50-2-5 56

