

298 RIDGE


Pl. Ave. No.

Name of Owner

TAX ID # 303.9-4-2

Labor and Mat'l. Report 19

GARAGE

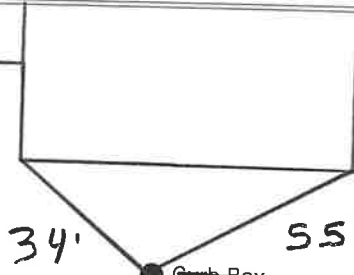

CLEANOUT

Main

Elev. of Main at tap

Gate at ●

● Gate at

● Curb Box

RECEIVED

JAN 15 2018

City of Glens Falls
W.W.T.P.

1939

St.

298

Pl.

Ave. No. 238

Ridge St


Name of Owner

Perkott

Labor and Mat'l. Report

May 9

1939

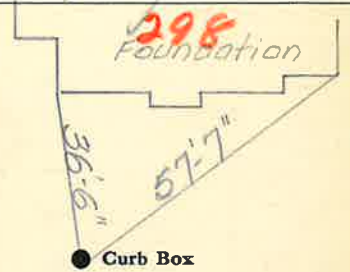

Elev. of Main at tap

5 1/2'

Gate at ●

● Gate at

● Curb Box

3/4" - 28' COPPER

JM

