


303 RIDGE

Pl. Ave. No.

Name of Owner

TAX ID # 303.9-6-7

Labor and Mat'l. Report 19

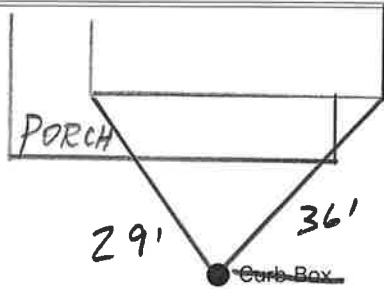

Main

Elev. of Main at tap

Gate at ●

● Gate at

● Curb Box

RECEIVED

JAN 15 2018

City of Glens Falls
W.W.T.P.


1935-91

303

Labor and Material Report June 28

1980

3/4" tap at 245 Ridge at

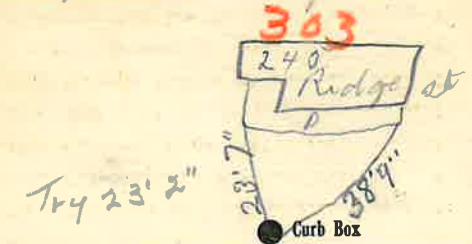

6" Main

Elev. of Main at tap 6"

Gate at ●

● Gate at

● Curb Box

Old tap shut off at main
Old " " " " 24 7/2 main

Before Paving Taps

3/4" - 9' COPPER

LABOR AND MATERIALS

_____	Copper	} Connection _____	\$ _____
_____	Lead		
_____	Curb	} _____ in. _____	\$ _____
	Cock Valve		
	T.S. & V.		
_____	Service box	{ Short 3-1/2 x 4-1/2 }	\$ _____
_____	Old returned		{ Long 4-1/2 x 5-1/2 }
_____	Ft. _____ in.	{ Copper } Pipe at _____	\$ _____
		{ G.I. }	
		{ C.I. }	
_____	Nipples _____	in. at _____	\$ _____
_____	Bushings _____	to _____ in. at _____	\$ _____
_____	Red'g		
_____	Inc'g		
_____	Union _____	in. at _____	\$ _____
_____	Meter _____	in. at _____	\$ _____
_____			\$ _____
_____	Compound Joints at _____		\$ _____
_____	Maintenance Foreman _____		\$ _____
_____	Hrs. Water Maint. Man - 1 at _____		\$ _____
_____	Hrs. Water Maint. Man - 2 at _____		\$ _____
_____	Hrs. Garage Foreman _____	at _____	\$ _____
_____	Hrs. Labor _____	at _____	\$ _____
_____	Hrs. Compressor at _____		\$ _____
_____			\$ _____
_____	Trucking _____		\$ _____
_____	Pav't Patch _____		\$ _____
_____			\$ _____
_____			\$ _____
Labor and Materials

1	Copper	} Connection ^{3/4"} _____	\$ 1.75
	Lead		
1	Curb	{ Cock Valve T.S. & V. } ^{3/4"} _____ in. _____	\$ 1.70
1	Service Box	{ Short 3 1/2 x 4 1/2 } _____	\$ 1.45
	Old returned		{ Long 4 1/2 x 5 1/2 } _____
9	Ft. ^{3/4"} _____ in.	{ Copper } Pipe at ^{3/4"} _____	\$ 1.72
		{ Galv. Iron } _____	
		{ Cast-Iron } _____	
	Nipples _____	in. at _____	\$ _____
	Bushings _____	to _____ in. at _____	\$ _____
	Red'g		\$ _____
	Inc'g		\$ _____
	Union _____	in. at _____	\$ _____
	Meter _____	in. at _____	\$ _____
			\$ _____
	Lbs. Br. Stone at _____		\$ _____
	Lbs. Sand at _____		\$ _____
	Bags Cement at _____		\$ _____
	Paving Brick	{ Mack } _____ at _____	\$ _____
		{ Red } _____	
		{ Asphalt } _____	
	Lead Joints at _____		\$ _____
	Leadite Joints at _____		\$ _____
8	Hrs. Foreman at _____	^{4 1/2 hr}	\$ 5.-
2	Hrs. Common Labor at _____	⁵⁰	\$ 1.50
15	Hrs. Common Labor at _____	⁴⁵	\$ 6.75
	Hrs. Mason at _____		\$ _____
	Hrs. Masons Helper at _____		\$ _____
	Hrs. Compressor at _____		\$ _____
	Compensation Ins _____		\$ 50
	Trucking _____		\$ 1.-
	Builders Use of Water _____		\$ _____
Total \$			20.37