


304 RIDGE. ^{SI} Pl. Ave. No. _____

Name of Owner
TAX ID # 303.9-4-4

Labor and Mat'l. Report 19

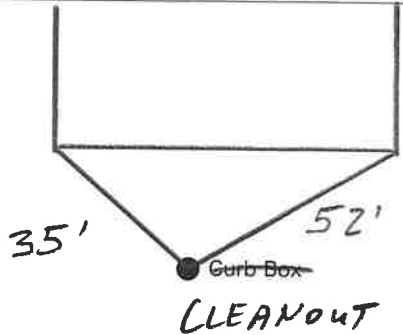

_____ Main Elev. of Main at tap _____

Gate at ● Gate at ●

● Curb Box

RECEIVED

JAN 15 2018

City of Glens Falls
W.W.T.P.

1 6 2-1937

Ridge St. ^B St. Pl. Ave. No. 304 242

Name of Owner
Sullivan

Labor and Mat'l. Report Nov 17 1937



6 Main Iron Main Elev. of Main at tap 6

Gate at ● Gate at ●

● Curb Box

New house.

3/4" - 31' copper

LABOR AND MATERIALS

Table with items like Copper Lead, Curb, Service box, Ft. in., Nipples, Bushings, Red'g, Inc'g, Union, Meter, Compound Joints, Maintenance Foreman, Hrs. Water Maint. Man, Hrs. Garage Foreman, Hrs. Labor, Hrs. Compressor at, Trucking, Pav't Patch, each with a price column.

Labor and Materials

Table with items like Copper Lead, Curb, Service Box, Ft., Nipples, Bushings, Red'g, Union, Meter, Lead Joints, Leadite Joints, Hrs. Foreman, Hrs. Chauffeur, Hrs. Tapper, Hrs. Labor, Hrs. Compressor at, Compensation Ins., Trucking, Builders Use of Water, and a handwritten total of 24.82.