


Labor and Materials

| | | | | |
|----------|------------------------|---------------------|----|---------|
| 1 | Copper | Connection | 3 | \$ 2.60 |
| 1 | Curb | Cock | 3 | \$ 2.27 |
| 1 | Service Box | Short 3/4" x 1/2" | 4 | \$ 1.38 |
| | Old returned | Buff. or Rdway | | |
| 9 | Pt. 3/4 in. | Copper Pipe at | 18 | \$ 1.62 |
| | Nipples | in. at | | \$ |
| | Bushings | to in. at | | \$ |
| | Red'g Inc'g | Couplings to in. at | | \$ |
| | Union | in. at | | \$ |
| | Meter | in. at | | \$ |
| | Lbs. Br. Stone | at | | \$ |
| | Lbs. Sand | at | | \$ |
| | Bags Cement | 'at | | \$ |
| | Paving Brick | Mack Red Asphalt at | | \$ |
| | Lead Joints | at | | \$ |
| | Leadite Joints | at | | \$ |
| 3 | Hrs. Foreman | at | | \$ 1.88 |
| 12 | Hrs. Common Labor | at | | \$ 5.40 |
| | Hrs. Common Labor | at | | \$ |
| | Hrs. Mason | at | | \$ |
| | Hrs. Mason's Helper | at | | \$ |
| | Hrs. Compressor | at | | \$ |
| | Compensation Ins | | | \$.73 |
| | Trucking | | | \$ 1.00 |
| | Builders' Use of Water | | | \$ |
| Total \$ | | | | 16.38 |

31-19 307 Apr. 9 1921

Labor and Material Report
297, 247 1/2 Ridge St.

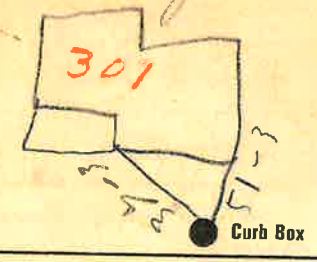

4 Main Elev of Main at tap 4 1/2
Gate at #305- TAX ID # 303.9-6-6 Gate at

● Curb Box

Tap made on
Hartford Ave.

3/4" - 9' Copper