


308 RIDGE

St. Ave. No.

Name of Owner

TAX ID # 3039-2-1

Labor and Mat'l. Report 19

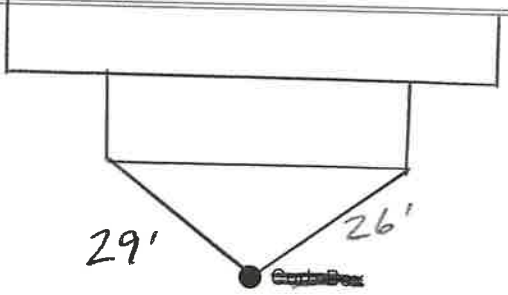

CLEANOUT

Main Elev. of Main at tap

Gate at ● Gate at ●

● Curb Box

RECEIVED

JAN 15 2018

City of Glens Falls
W.W.T.P.

87 1942

St. Ave. No. 308 249


Ridge

Name of Owner

Matteson

Labor and Mat'l. Report

June 29 1942

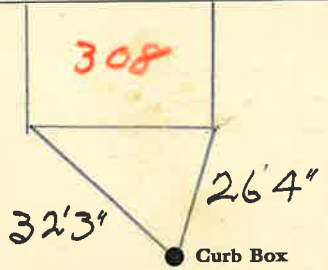

6 Main Elev. of Main at tap 6

Gate at ● Gate at ●

● Curb Box

3/4" - 31' COPPER

