


310 RIDGE
St. Pl. Ave. No.

Name of Owner
TAX ID # 303.9-2-2

Labor and Mat'l. Report 19

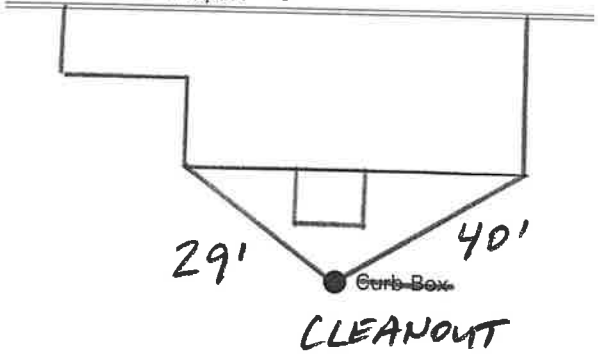

Main Elev. of Main at tap

Gate at • Gate at •

• Curb Box

RECEIVED


JAN 15 2018

**City of Glens Falls
W.W.T.P.**

Ridge St. Pl. Ave. No. 310
Name of Owner

Moriarty

Labor and Mat'l. Report Oct. 14 19 40

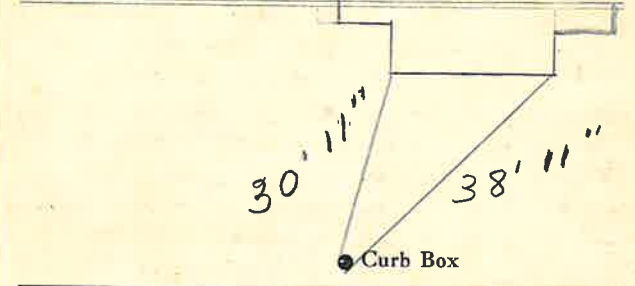

6" Main Elev. of Main at tap 6"

Gate at • Gate at •

• Curb Box

3/4" - 32' COPPER

