


313 RIDGE

St. Ave. No.

Name of Owner

TAX ID # 303.9-7-18

Labor and Mat'l. Report 19

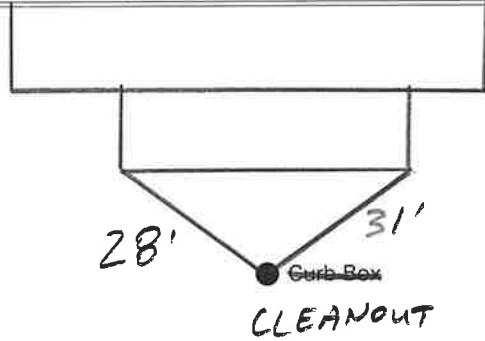

Main

Elev. of Main at tap

Gate at ●

● Gate at

● Curb Box

**RECEIVED**

**JAN 15 2018**

**City of Glens Falls  
W.W.T.P.**

Ridge

St. Ave. No. 313 257


Name of Owner

Fred N. Pulver

Labor and Mat'l. Report

July 6

194

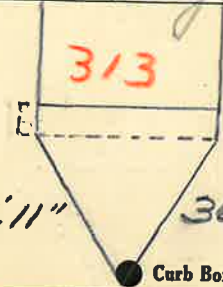

6" Main

Elev. of Main at tap 6'

Gate at ●

● Gate at

● Curb Box

3/4" - 15' copper

