

317 RIDGE


St. Ave. No.

Name of Owner

TAX ID # 303.9-7-16

Labor and Mat'l. Report 19

317

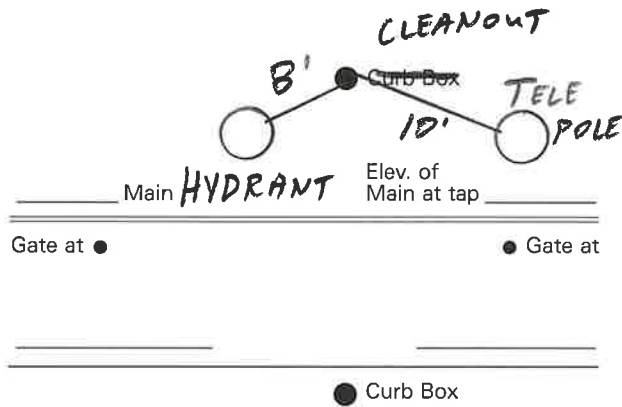

RECEIVED

JAN 15 2018

City of Glens Falls
W.W.T.P.

317-14 317

Labor and Material Report June 23 19 32

261 Ridge St

A schematic diagram of a water main layout. It shows a diagonal line representing the main. At the top left end is a circle labeled '261'. At the bottom right end is a circle labeled 'Curb Box'. A line labeled '317' connects the '261' to the curb box. Below the main, there are two 'Gate at' points marked with dots. To the right of the main, there is a label 'Elev. of Main at tap' with a value '5.5' written next to it.

2 Houses on same
Pipe not shut off at
Main # 259 + 261

3/4" - 18' copper

OK [Signature]

LABOR AND MATERIALS

Copper	}	Connection	\$	
Lead				
Curb	}	Cock Valve T.S. & V.		in. \$
Service box	}	Short 3-1/2 x 4-1/2		\$
Old returned	}	Long 4-1/2 x 5-1/2		\$
Ft. _____ in.	}	Copper G.I. C.I.		Pipe at \$
Nipples		in. at	\$	
Bushings		to _____ in. at	\$	
Red'g				
Inc'g				
Union		in. at	\$	
Meter		in. at	\$	
			\$	
Compound Joints at			\$	
Maintenance Foreman			\$	
Hrs. Water Maint. Man - 1 at			\$	
Hrs. Water Maint. Man - 2 at			\$	
Hrs. Garage Foreman		at	\$	
Hrs. Labor		at	\$	
Hrs. Compressor at			\$	
			\$	
Trucking			\$	
Pav't Patch			\$	
			\$	
			\$	
			\$	
			\$	

Labor and Materials

Copper	}	Connection	\$	
Lead				
Curb	}	Cock Valve T.S. & V.		in. \$
Service Box	}	Short 3 1/2 x 4 1/2		\$
Old returned	}	Long 4 1/2 x 5 1/2		\$
		Part or Rdway		\$
14 Ft. in.	}	Copper Cast Iron		Pipe at \$
Nipples		in. at	\$	
Bushings		to _____ in. at	\$	
Red'g				
Inc'g				
Union		in. at	\$	
Meter		in. at	\$	
Lbs. Br. Stone at			\$	
Lbs. Sand at			\$	
Bags Cement at			\$	
Paving Brick		{ Mack Red Asphalt } at	\$	
Lead Joints at			\$	
Leadite Joints at			\$	
16 Hrs. Foreman at			\$	10.00
7 Hrs. Common Labor at			\$	3.15
Hrs. Common Labor at			\$	
Hrs. Mason at			\$	
Hrs. Masons Helper at			\$	
Hrs. Compressor at			\$	
Compensation Ins			\$	40
Trucking			\$	1.00
Builders Use of Water			\$	5.00

Total \$ 27.36