


LABOR AND MATERIALS

|     |                       |                       |                            |            |
|-----|-----------------------|-----------------------|----------------------------|------------|
| 1   | Copper Lead           | Connection            | 1/2 x 3/4                  | \$         |
| 1/4 | Curb                  | Cock Valve T. S. & V. | 1/2 in.                    | \$         |
| 1/4 | Service Box           | Short 3/2 x 4 1/2     | } N                        | \$         |
|     | Old returned          | Long 4 1/2 x 5 1/2    |                            |            |
| 3   | Ft.                   | 3/4 in.               | Copper Galv Iron Cast Iron | Pipe at \$ |
|     | Nipples               | in. at                |                            | \$         |
|     | Bushings              | to in. at             |                            | \$         |
|     | Red'g Inc'g           | Couplings to in. at   |                            | \$         |
|     | Union                 | in. at                |                            | \$         |
|     | Meter                 | in. at                |                            | \$         |
|     | Lead Joints           | at                    |                            | \$         |
|     | Leadite Joints        | at                    |                            | \$         |
|     | Hrs. Foreman          | at                    |                            | \$         |
|     | Hrs. Chauffeur        | at                    |                            | \$         |
|     | Hrs. Tapper           | at                    |                            | \$         |
|     | Hrs. Labor            | at                    |                            | \$         |
|     | Hrs. Labor            | at                    |                            | \$         |
|     | Hrs. Compressor       | at                    |                            | \$         |
|     | Compensation Ins.     |                       |                            | \$         |
|     | Trucking              |                       |                            | \$         |
|     | Builders Use of Water |                       |                            | \$         |
|     | Tapping               |                       |                            | \$         |
|     |                       |                       |                            | \$         |
|     |                       |                       |                            | \$         |
|     |                       |                       |                            | \$         |

Old Terra Cotta 3180r  
Houston, St. 320  
Ph  
Bridge Ave. No. 260  
Name of Owner Corner Meadows  
Washer Brook Rd.

Labor and Mat'l. Report Sept 6 1939

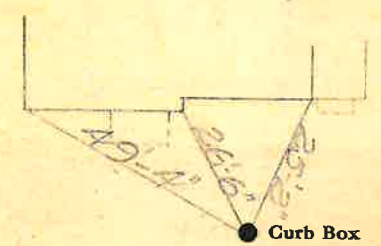

4 601 Main Elev. of Main at tap 5'  
Gate at ● ● Gate at

● Curb Box

3/4 - 3' copper  
FM.  
no charge for this trip to