

Ridge

St. ~~Pl.~~
Ave. No. 28


Name of Owner

Howard LaRose II

Labor and Mat'l. Report

Oct. 1977

#28

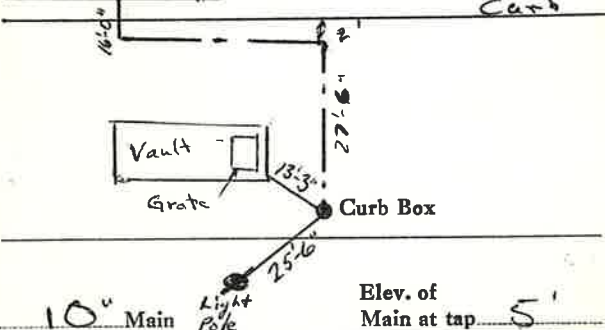

Gate at ●

● Gate at

● Curb Box

33' to MAIN ?


LSM-5C-6-1-67

28 RIDGE

Pl. Ave. No.

Name of Owner

Labor and Mat'l. Report 19

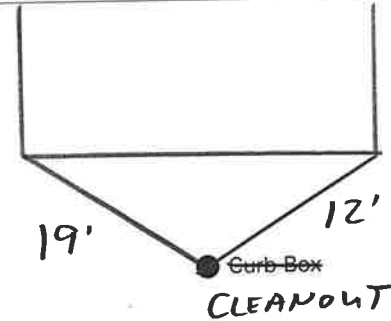

Main

Elev. of Main at tap

Gate at ●

● Gate at

TAX ID# 302.20-30-5

● Curb Box

RECEIVED

JAN 15 2018

City of Glens Falls
W.W.T.P.

Labor and Materials

1	Copper	Connection	3/4"	\$ 2.60
	Lead			
1	Curb	Cock Valve	3/4" in.	\$ 2.27
		T.S. & V.		
1	Service Box	Short 3/4" x 1 1/4"		\$ 1.38
	Old returned	Long 4 1/2" x 5 1/2"		
		Buff. or Rdway		
33	Ft. 3/4"	Copper	Pipe at	\$ 5.94
		Galv. Iron		
		Cast Iron		
	Nipples	in. at		\$
	Bushings	to in. at		\$
	Red'g Inc'g	Couplings	to in. at	\$
	Union	in. at		\$
	Meter	in. at		\$
	Lbs. Br. Stone	at		\$
	Lbs. Sand	at		\$
	Bags Cement	at		\$
	Paving Brick	Mack Red Asphalt	at	\$
	Lead Joints	at		\$
	Leadite Joints	at		\$
10	Hrs. Foreman	at		\$ 6.25
6	Hrs. Common Labor	Tapper		\$ 3.00
25	Hrs. Common Labor	at		\$ 11.25
	Hrs. Mason	at		\$
	Hrs. Mason's Helper	at		\$
3	Hrs. Compressor	at		\$ 4.50
	Compensation Ins			\$.63
	Trucking			\$ 1.00
	Builders' Use of Water	Fetch		\$ 23.00
	Total			\$ 61.82

3/4" top at 18" Ridge

28-28A



10" Main Elev of Main at tap 5.6
 Gate at ● Gate at ●

● Curb Box

Old top shut off