


2 MEADOWBROOK St.  
Pl. Ave. No.

Name of Owner

Labor and Mat'l. Report 19

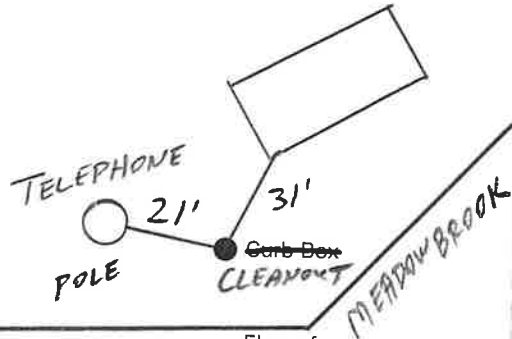

Main RIDGEST Elev. of Main at tap

Gate at ● Gate at ●

#1-TAX ID # 303.9-2-4

● Curb Box

**RECEIVED**

**JAN 15 2018**


**City of Glens Falls  
W.W.T.P.**

✓  
Meadow Brook St. Rd.  
Pl. Ave. No. 2

Name of Owner

Merwin Gray

Labor and Mat'l. Report Oct. 26 19 59

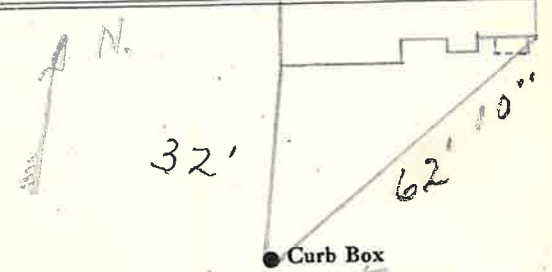

6" Main Elev. of Main at tap 5'

Gate at ● Gate at ●

● Curb Box

Tap on Ridge St.

## LABOR AND MATERIALS

_____	Copper } Connection _____	\$ _____
_____	Lead } _____	\$ _____
_____	Curb } Cock } _____ in.	\$ _____
	} Valve } _____	
	} T.S. & V. }	
_____	Service box { Short 3-1/2 x 4-1/2 }	\$ _____
_____	Old returned { Long 4-1/2 x 5-1/2 }	\$ _____
_____	Ft. _____ in. { Copper } Pipe at _____	\$ _____
	} G.I. }	
	} C.I. }	
_____	Nipples _____ in. at _____	\$ _____
_____	Bushings _____ to _____ in. at _____	\$ _____
_____	Red'g _____	\$ _____
_____	Inc'g _____	\$ _____
_____	Union _____ in. at _____	\$ _____
_____	Meter _____ in. at _____	\$ _____
_____	_____	\$ _____
_____	Compound Joints at _____	\$ _____
_____	Maintenance Foreman _____	\$ _____
_____	Hrs. Water Maint. Man - 1 at _____	\$ _____
_____	Hrs. Water Maint. Man - 2 at _____	\$ _____
_____	Hrs. Garage Foreman _____ at _____	\$ _____
_____	Hrs. Labor _____ at _____	\$ _____
_____	Hrs. Compressor at _____	\$ _____
_____	_____	\$ _____
_____	Trucking _____	\$ _____
_____	Pav't Patch _____	\$ _____
_____	_____	\$ _____
_____	_____	\$ _____
## LABOR AND MATERIALS

1	Copper } Connection <sup>3/4</sup> _____	\$ _____
	Lead } _____	
1	Curb } Cock } <sup>3/4</sup> in.	\$ _____
	} Valve } _____	
	} T.S. & V. }	
1	Service box { Short 3 1/2 x 4 1/2 }	\$ _____
	Old returned { Long 4 1/2 x 5 1/2 }	\$ _____
	} Buff or Rdway }	
50	Ft. <sup>3/4</sup> in. { Copper } Pipe at _____	\$ _____
	} G.I. }	
	} C.I. }	
_____	Nipples _____ in. at _____	\$ _____
_____	Bushings _____ to _____ in. at _____	\$ _____
_____	Red'g } Coupl'gs _____ to _____ in. at _____	\$ _____
	Inc'g }	
_____	Union _____ in. at _____	\$ _____
_____	Meter _____ in. at _____	\$ _____
_____	Lead Joints at _____	\$ _____
_____	Compound Joints at _____	\$ _____
_____	Maintenance Foreman _____	\$ _____
_____	Hrs. Water Maint. Man - 1 at _____	\$ _____
_____	Hrs. Water Maint. Man - 2 at _____	\$ _____
_____	Hrs. Garage Foreman _____ at _____	\$ _____
_____	Hrs. Labor _____ at _____	\$ _____
_____	Hrs. Compressor at _____	\$ _____
_____	Compensation Ins. at \$ _____ per C	\$ _____
_____	Trucking _____	\$ _____
_____	Pav't Patch _____	\$ _____
_____	Tap by Giggord + Co	\$ _____
_____	10-26-59.	\$ _____
_____	_____	\$ _____
_____	O'head _____	\$ _____
_____	_____	\$ _____

318? 715  
 Labor and Material Report *June 25* 1936

320 Main  
 Curb Box & 4" Main  
 16 Johnson Wash  
 260 Ridge St

● Curb Box

Main Elev of Main at tap

Gate at ● ● Gate at

Elev of Main at tap

● Curb Box

260 Ridge St  
 16 Johnson Wash  
 Curb Box & 4" Main  
 320 Main

Labor and Material Report *June 25* 1936

318? 715  
 Labor and Material Report *June 25* 1936

320 Main  
 Curb Box & 4" Main  
 16 Johnson Wash  
 260 Ridge St

● Curb Box

Main Elev of Main at tap

Gate at ● ● Gate at

Elev of Main at tap

● Curb Box

260 Ridge St  
 16 Johnson Wash  
 Curb Box & 4" Main  
 320 Main

Labor and Material Report *June 25* 1936

### Labor and Materials

.....Copper } Connection.....	\$.....
.....Lead } .....	\$.....
.....Curb { Cock Valve } .....in .....	\$.....
.....T.S.&V. } .....	\$.....
.....Service Box { Short 3½x4½ Long 4½x5½ } .....	\$.....
.....Old returned { Buff. or Rdway } .....	\$.....
.....Ft.....In. { Copper Galv. Iron } Pipe at .....	\$.....
.....Cast Iron } .....	\$.....
.....Nipples .....in. at .....	\$.....
.....Bushings .....to .....in. at.....	\$.....
.....Red'g } Couplings.....to.....in.at....	\$.....
.....Inc'g } .....	\$.....
.....Union.....in. at .....	\$.....
.....Meter.....in. at .....	\$.....
.....Lbs. Br. Stone at .....	\$.....
.....Lbs. Sand at .....	\$.....
.....Bags Cement at .....	\$.....
.....Paving Brick { Mack Red } at .....	\$.....
.....Asphalt } .....	\$.....
.....Lead Joints at .....	\$.....
.....Leadite Joints at .....	\$.....
.....Hrs. Foreman at .....	\$.....
.....Hrs. Common Labor at .....	\$.....
.....Hrs. Common Labor at .....	\$.....
.....Hrs. Mason at .....	\$.....
.....Hrs. Masons Helper at .....	\$.....
.....Hrs. Compressor at .....	\$.....
.....Compensation Ins .....	\$.....
.....Trucking .....	\$.....
.....Builders Use of Water .....	\$.....
Total \$.....	