


Labor and Material Report

Apr 20 1921

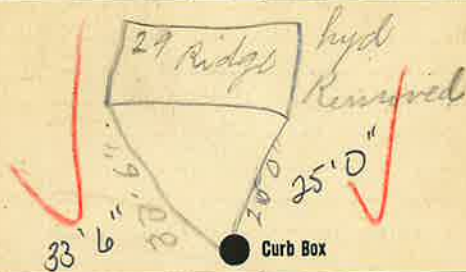

6" Main Elev. of Main at tap 472.6  
 Gate at ● Gate at ●

● Curb Box

1-6" gate Valve  
 1-6" length 13 ft  
 1-6" Ell  
 1-6" Piece 26" long  
 Location & Date

Ridge St. Pl. Ave. No. 29 23  
 Name of Owner

Labor and Mat'l. Report MAY 25 1921




Main Elev. of Main at tap  
 Gate at ● Gate at ●


● Curb Box

REPAIRED MAR 29-1972  
See Attached Note

29 Ridge St

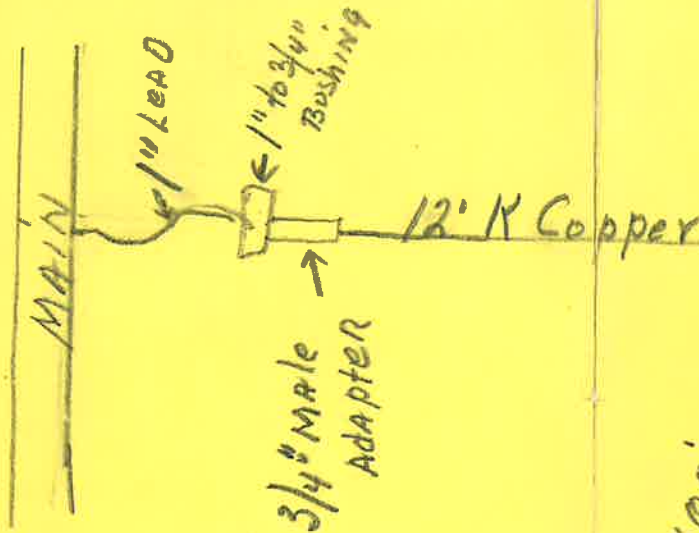

VAN the Shoe MAN.

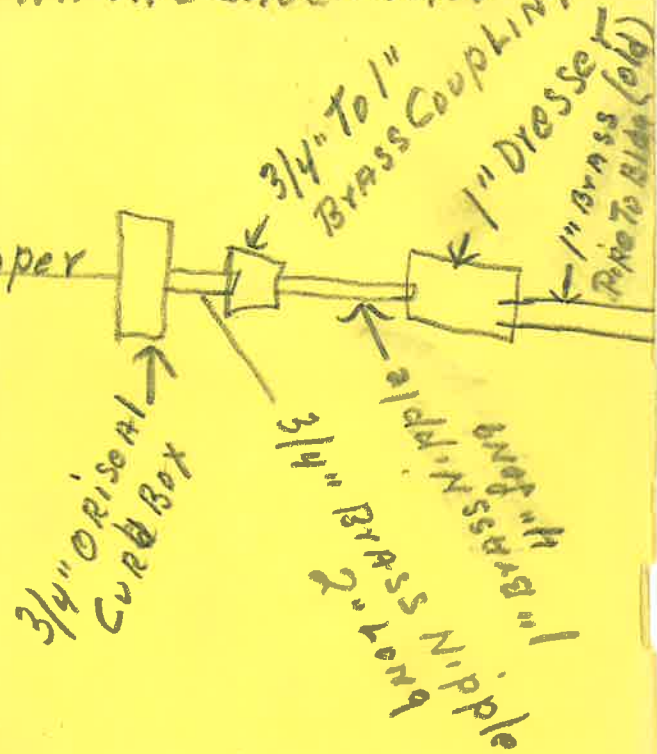

MAR 29-1972

