

### Labor and Materials

1	Copper	Connection	1"	\$ 3.81
	Lead			
1	Curb	Cock Valve	in.	\$ 3.59
		T-S & V		
1	Service Box	Short 3 1/2 x 1 1/2		\$ 1.38
	Old returned	Long 4 1/2 x 5 1/2		
		Buff. or Rdway		
33	Ft. /"	Copper Galv. Iron	Pipe at	\$ 7.26
		Cast Iron		
	Nipples	in. at		\$
	Bushings	to in. at		\$
	Red'g Inc'g	Couplings	to in. at	\$
	Union	in. at		\$
	Meter	in. at		\$
	Lbs. Br. Stone	at		\$
	Lbs. Sand	at		\$
	Bags Cement	at		\$
	Paving Brick	Mack Red Asphalt	at	\$
	Lead Joints	at		\$
	Leadite Joints	at		\$ 13.13
21	Hrs. Foreman	at		\$ 5.50
11	Hrs. Common Labor	at Tapper		\$ 14.85
33	Hrs. Common Labor	at		\$
	Hrs. Mason	at		\$
	Hrs. Mason's Helper	at		\$ 6.-
4	Hrs. Compressor	at		\$ 1.00
	Compensation Ins			\$ 1.-
	Trucking			\$ 46.-
	Builders' Use of Water	Patches		\$
Total \$				103.54


31-150

30-37

Labor and Material Report

1931

1" tap at 204 2 1/2" x 22" x 22 1/2" Ridge

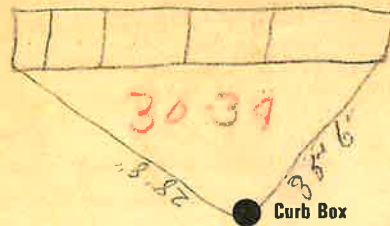

10" Main

Elev of Main at tap 56'

Gate at ●

● Gate at

● Curb Box

Old tap shut off

Repaired connection

28.00

1" Copper  
33' to MAIN