

St.
Pl.
Ave. No. 34-38

Ridge

Name of Owner
City Hall

Labor and Mat'l. Report May 1 1941

10" Main Elev. of Main at tap 5'

Gate at ● PARKING LOT ● Gate at

#38 TAX ID# 302.20-30-8

● Curb Box

3/4" copper
33' to MAIN

For Pressure Gauge
WATER DEPT
to be billed to M.D.

St.
Pl.
Ave. No. 42

Ridge

Name of Owner
City Hall

Labor and Mat'l. Report Feb 3-5 1958

10" Main Elev. of Main at tap 5 1/2'


Gate at ● City Hall ● Gate at

TAX ID 302.20-30-9

● Curb Box

1 1/2" copper
53' to MAIN

LSM-5C-2-5 56

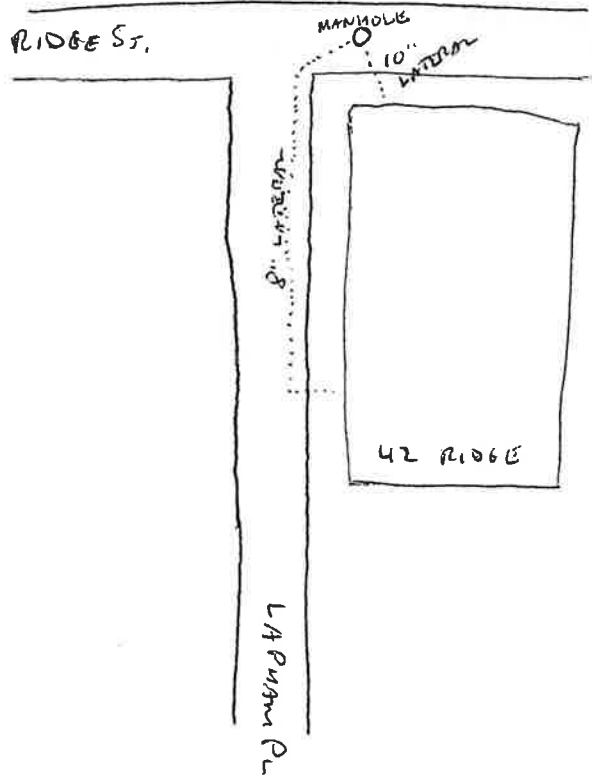

SEWER LATERALS
for
CITY HALL

Ridge

St. Ave. No. 34-38

Name of Owner

Labor and Mat'l. Report 19

42 Fire house	46 City Hall
------------------	-----------------

116
35-5
84-8

● Curb Box

Main Elev. of Main at tap.....

Gate at ● Gate at

● Curb Box

Tap for pressure gage
in City Hall.
This also supplied drinking
fountain in old fire station.

LABOR AND MATERIALS

/	Copper Lead	} Connection	3/4	\$ 1.35
/	Curb	{ Cock Valve T. S. & V.	3/4 in.	\$ 1.80
	Service Box Old returned	{ Short 3 1/2 x 4 1/2 Long 4 1/2 x 5 1/2 Buff or Rdway	Same	\$ —
33	Ft.	3/4 in.	{ Copper Galv. Iron Cast-iron	Pipe at \$ 5.94
	Nipples	in. at		\$
	Bushings	to in. at		\$
	Red'g Inc'g	} Couplings to in. at		\$
	Union	in. at		\$
	Meter	in. at		\$
	Lead Joints	at		\$
	Leadite Joints	at		\$
	Hrs. Foreman	at		\$
	Hrs. Chauffeur	at		\$
	Hrs. Tapper	at		\$
	Hrs. Labor	at		\$
	Hrs. Labor	at		\$
	Hrs. Compressor	at		\$
	Compensation Ins.			\$
	Trucking			\$
	Builders Use of Water			\$
	Tap by Miller			\$
				\$
				\$
				\$
				\$

LABOR AND MATERIALS

/	Copper Lead	} Connection	1 1/2"	\$
/	Curb	{ Cock Valve T. S. & V.	1/2 in.	\$
/	Service box Old returned	{ Short 3 1/2 x 4 1/2 Long 4 1/2 x 5 1/2 Buff or Rdway	Small	\$
53	Ft.	1/2 in.	{ Copper G.I. G.I.	Pipe at \$
	Nipples	in. at		\$
	Bushings	to in. at		\$
	Red'g Inc'g	} Coupl'gs to in. at		\$
	Union	in. at		\$
	Meter	in. at		\$
	Lead Joints	at		\$
	Compound Joints	at		\$
	Maintenance Foreman			\$
	Hrs. Water Maint. Man	—1 at		\$
	Hrs. Water Maint. Man	—2 at		\$
	Hrs. Garage Foreman	at		\$
	Hrs. Labor	at		\$
	Hrs. Compressor	at		\$
	Compensation Ins.	at \$ per C		\$
	Trucking			\$
	Pav't Patch			\$
	Tap by Gifford, Miller & Co.			\$
				\$
				\$
	O'head			\$
				\$