

LABOR AND MATERIALS

Copper	} Connection	_____	\$ _____	
Lead				
Curb	} Cock	_____ in.	\$ _____	
				} Valve
Service box	} { Short 3 1/2 x 4 1/2 Long 4 1/2 x 5 1/2 Buff or Rdway	_____	\$ _____	
Old returned				
Ft. _____ in.	} { Copper G. I. C. I.	Pipe at _____	\$ _____	
Nipples _____ in.		at _____	\$ _____	
Bushings _____ to _____ in.		at _____	\$ _____	
Red'g } Inc'g }	} Coupl'gs	_____ to _____ in.	at _____ \$ _____	
Union _____ in.		at _____	\$ _____	
Meter _____ in.	at _____	\$ _____		
Lead Joints	at _____	\$ _____		
Compound Joints	at _____	\$ _____		
Maintenance Foreman	at _____	\$ _____		
Hrs. Water Maint. Man—1	at _____	\$ _____		
Hrs. Water Maint. Man—2	at _____	\$ _____		
Hrs. Garage Foreman	at _____	\$ _____		
Hrs. Labor—	at _____	\$ _____		
Hrs. Compressor	at _____	\$ _____		
Compensation Ins. at \$ _____	per C _____	\$ _____		
Trucking	_____	\$ _____		
Pav't Patch	_____	\$ _____		
O'head	_____	\$ _____		


CROWN HIGH RISE

St. \_\_\_\_\_  
Pt. \_\_\_\_\_  
Ave. No. **43**

RIDGE

Name of Owner \_\_\_\_\_

Labor and Mat'l. Report *measured* **OCT. 28** 19**81**

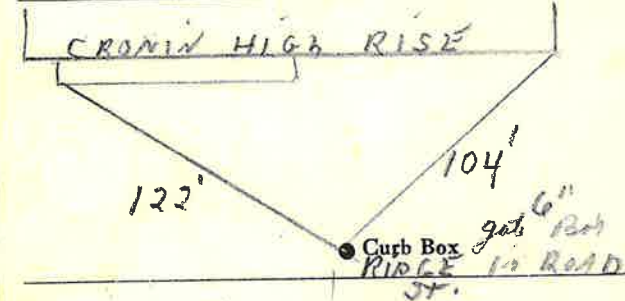

Main \_\_\_\_\_ Elev. of Main at tap \_\_\_\_\_

Gate at • \_\_\_\_\_ • Gate at \_\_\_\_\_

TAX ID # 303.17-16-3.1

• Curb Box