

LABOR AND MATERIALS


Copper	} Connection	\$.....
Lead			
1 Curb	{ Clock Valve T. S. & V. }	{ 1 1/4 in.	\$.....
Service box	{ Short 3/4 X 4 1/2 Long 4 1/2 X 5 1/2 Buff or Rdway }	{ Saml	\$.....
Old returned			
11 Ft. 1 1/4 in.	{ Copper Galv. Iron Cast Iron }	{ Brass Pipe at	\$.....
Nipples	in. at		\$.....
Bushings	to	in. at	\$.....
Red'g Inc'g	} Couplings	to	in. at
Union		in. at	\$.....
Meter	in. at	\$.....	
Lead Joints at		\$.....	
Compound Joints at		\$.....	
Hrs. Foreman at		\$.....	
Hrs. Chauffeur at		\$.....	
Hrs. Tapper at		\$.....	
Hrs. Labor at		\$.....	
Hrs. Labor at		\$.....	
Hrs. Compressor at		\$.....	
Compensation Ins.		\$.....	
Trucking		\$.....	
Builders Use of Water		\$.....	
<i>copy by Magman</i>			\$.....
			\$.....
			\$.....
St. *Ridge*
 Pl. *7 1/2*
 Ave. No. *7 1/2*

Name of Owner

Magman

Labor and Mat'l. Report *Sept 19 19 47*

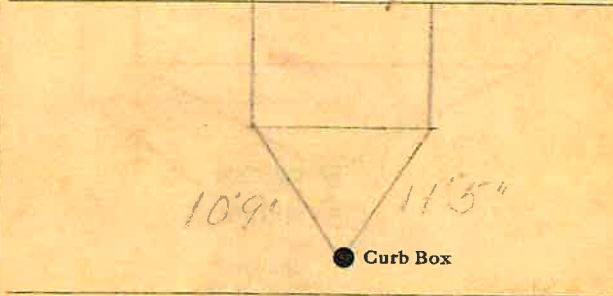

10 Main Elev. of Main at tap *6*

Gate at ● ● Gate at

● Curb Box

1 1/2" BRASS

11' to MAIN