


**Labor and Materials**

1	Copper } Connection /"	\$ 3.81
	Lead	
1	Curb { Cock } /" in.	\$ 3.59
	Valve } P.S. & V.	
1	Service Box { Short 3/4x1/2 } .	\$ 1.59
	Old returned { Long 1/2x5/8 } Buff. or Rdway	
17	Ft. 1" in. { Copper } Pipe at	\$ 3.04
	Galv. Iron } Cast Iron	
	Nipples . . . . . in. at . . . . .	\$ .
	Bushings . . . . . to . . . . . in. at . . . . .	\$ .
	Red'g } Couplings . . . . . to . . . . . in. at . . . . .	\$ .
	Inc'g }	
	Union . . . . . in. at . . . . .	\$ .
	Meter . . . . . in. at . . . . .	\$ .
	Lbs. Br. Stone at . . . . .	\$ .
	Lbs. Sand at . . . . .	\$ .
	Bags Cement at . . . . .	\$ .
	Paving Brick { Mack } at . . . . .	\$ .
	Red } Asphalt }	
	Lead Joints at . . . . .	\$ .
	Leadite Joints at . . . . .	\$ .
6	Hrs. Foreman at . . . . .	\$ 3.75
14	Hrs. Common Labor at . . . . .	\$ 6.30
	Hrs. Common Labor at . . . . .	\$ .
	Hrs. Mason at . . . . .	\$ .
	Hrs. Mason's Helper at . . . . .	\$ .
2	Hrs. Compressor at . . . . .	\$ 3.00
	Compensation Ins . . . . .	\$ .31
	Trucking . . . . .	\$ 1.00
	Builders' Use of Water . . . . .	\$ 23.00
		\$ 49.39

Do Hoyle is at 10' for measure  
 from 47' 4" height to top

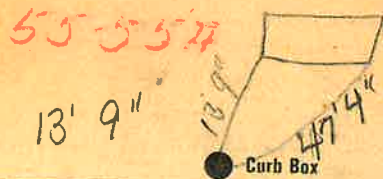

10" Main  
 Elev of Main at tap 12.12  
 Gate at ● Gate at ●

● Curb Box

Old top shut off  
 Service to GARAGE IN REAR  
 DISCONTINUED - DISCONNECTED  
 IN ALLEY NEAR SERVICE TO THIS  
 Bldg. 9-25-70

1" COPPER  
 17' to MAIN