

LABOR AND MATERIALS


1 Copper } Connection 1 1/4" \$
~~Lead~~ }
 1 Curb } Cock } 1 1/4 in. ORISEAL \$
 } Valve }
 } F.S. & V. }
 1 Service box } {Short 3 1/2 x 4 1/2 } 40-51
 Old returned } {Long 4 1/2 x 5 1/2 } ORISEAL
 } Buff or Rdway }
 17 Ft 1 1/4 in. } {Copper } Pipe at \$
 } {C.I. }
 } {C.I. }
 Nipples in. at \$
 Bushings to in. at \$
 Red'g } Coupl'gs to in. at \$
 Inc'g }
 Union in. at \$
 Meter in. at \$
 Lead Joints at \$
 Compound Joints at \$
 Maintenance Foreman \$
 Hrs. Water Maint. Man-1 at \$
 Hrs. Water Maint. Man-2 at \$
 Hrs. Garage Foreman at \$
 Hrs. Labor at \$
 Hrs. Compressor at \$
 Compensation Ins. at \$ per C \$
 Trucking \$
 Pav't Patch \$
TAP MADE BY PECK & CO \$
 O'head APRIL-18-1972 \$

Ridge

St. 76
 Ave. No.

Name of Owner
Hildreth Project

Labor and Mat'l. Report APRIL-18-1972

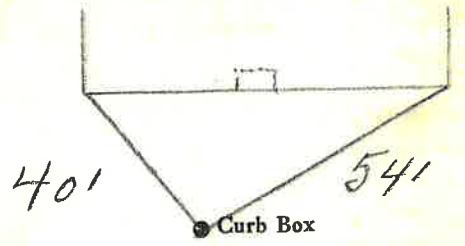

10' Main Elev. of Main at tap 5 1/2'
 Gate at • Gate at

• Curb Box
1 1/4" COPPER
17' TO MAIN