

Labor and Materials

1	Copper } Connection ^{3/4}	\$ 3.20
	Lead	
1	Curb } Cock	\$ 1.50
	Valve } ^{3/4} in.	
	T-S. & V.	
1	Service Box } Short 3 1/2 x 4 1/2	\$ 1.40
	Old returned } Long 4 1/2 x 5 1/2	
	Buff. or Rdway	
28	Ft. ^{3/4} in. } Copper	\$ 6.66
	Galv. Iron	
	Cast Iron	
	Pipe at	
	Nipples..... in. at.....	\$
	Bushings..... to..... in. at.....	\$
1	Red'g } Couplings ^{Brass}	\$ 1.5
	Inc'g } to..... in. at.....	
	Union..... in. at.....	\$
	Meter..... in. at.....	\$
	Lbs. Br. Stone at.....	\$
	Lbs. Sand at.....	\$
	Bags Cement at.....	\$
	Paving Brick } Mack	\$
	Red	
	Asphalt }	
	at.....	\$
	Lead Joints at.....	\$
	Leadite Joints at.....	\$
10	Hrs. Foreman at..... ^{6.25}	\$ 6.25
	Hrs. Common Labor at.....	\$
28	Hrs. Common Labor at..... ^{4.07}	\$ 11.38
	Hrs. Mason at.....	\$
	Hrs. Mason's Helper at.....	\$
2	Hrs. Compressor at.....	\$ 4.00
	Compensation Ins.....	\$
	Trucking.....	\$ 1.00
	Builders' Use of Water.....	\$
	Total	\$ 34.54


Labor and Material Report

June 17

1927

3/4 tap at 72 Ridge st

96

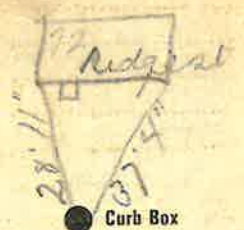

10" Main

Elev. of Main at tap 6.11

Gate at ●

● Gate at

● Curb Box

Shut off at Curb

7-3-1927

House to Be

Razed