

## LABOR AND MATERIALS


Copper	} Connection							
Lead				\$				
Curb	} Cock Valve T.S. & V.	} _____ in.			\$			
Service box	{ Short 3-1/2 x 4-1/2 Long 4-1/2 x 5-1/2 }			\$				
Old returned								
Ft. _____ in.	{ Copper G.I. C.I. }	} Pipe at		\$				
Nipples	_____ in.	at		\$				
Bushings	_____ to _____ in.	at		\$				
Red'g								
Inc'g								
Union	_____ in.	at		\$				
Meter	_____ in.	at		\$				
				\$				
Compound Joints	at			\$				
Maintenance Foreman				\$				
Hrs. Water Maint. Man - 1	at			\$				
Hrs. Water Maint. Man - 2	at			\$				
Hrs. Garage Foreman	at			\$				
Hrs. Labor	at			\$				
Hrs. Compressor	at			\$				
				\$				
Trucking				\$				
Pav't Patch				\$				
				\$				
				\$				
				\$				
				\$				

99 RIDGE

Pl. Ave. No. \_\_\_\_\_

Name of Owner \_\_\_\_\_

Labor and Mat'l. Report 19 \_\_\_\_\_

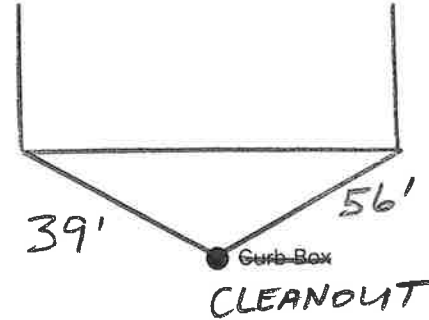

Elev. of Main at tap \_\_\_\_\_

Gate at ● \_\_\_\_\_ ● Gate at \_\_\_\_\_

TAX ID# 303.17-9-5

● Curb Box

RECEIVED

JAN 15 2018

City of Glens Falls  
W.W.T.P.